


T.39S.R.8W.W.M.

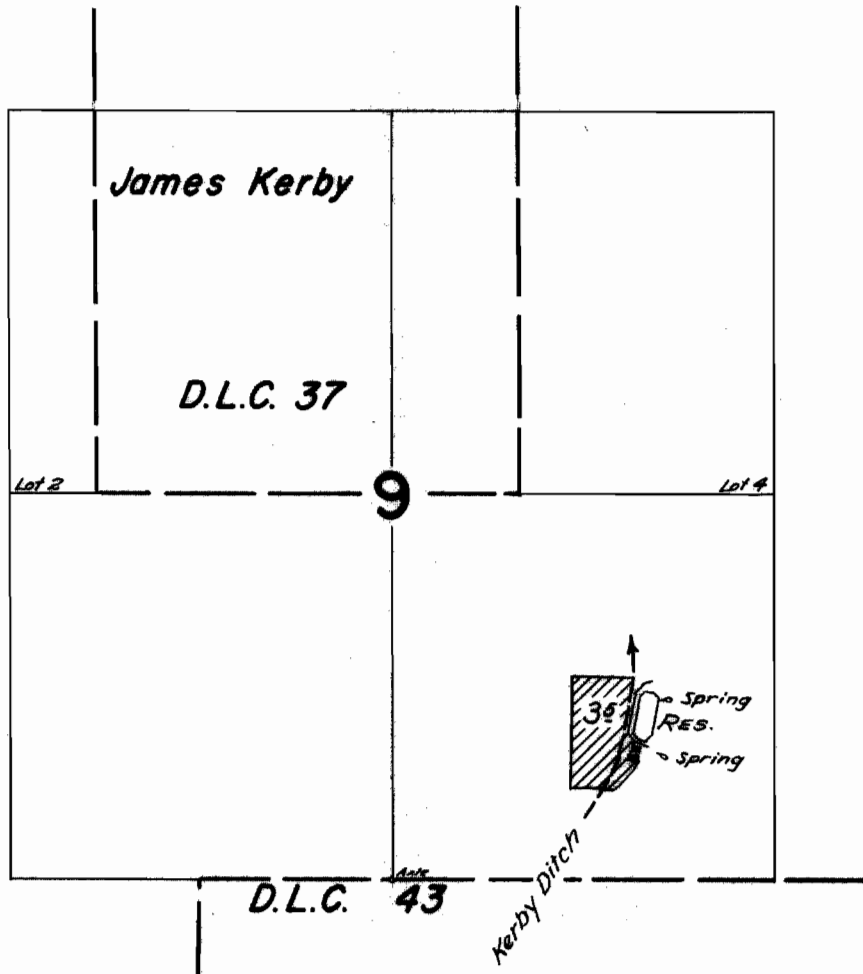

Scale: 1" = 660'

FINAL PROOF SURVEY UNDER

R-34460 R-2586
Application No. 34461. Permit No. 27187....
IN NAME OF

DALE CALL

Surveyed June 7, 1963, by