


T.39S.R.8 W.W.M.

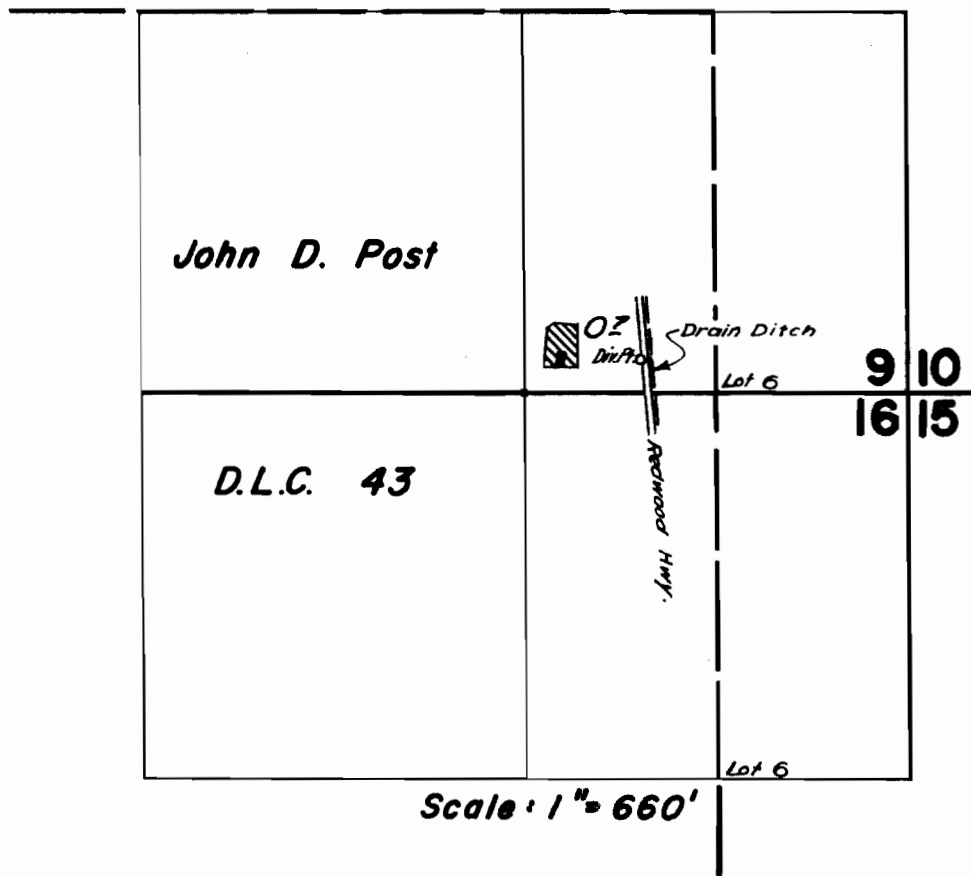

**FINAL PROOF SURVEY**  
UNDER

Application No. 34717.... Permit No. 27467....  
IN NAME OF

.....WM. A. MINNIEAR.....

Surveyed July 12, 1963, by *R. Jackson*