


T.41S.R.8W.W.M.

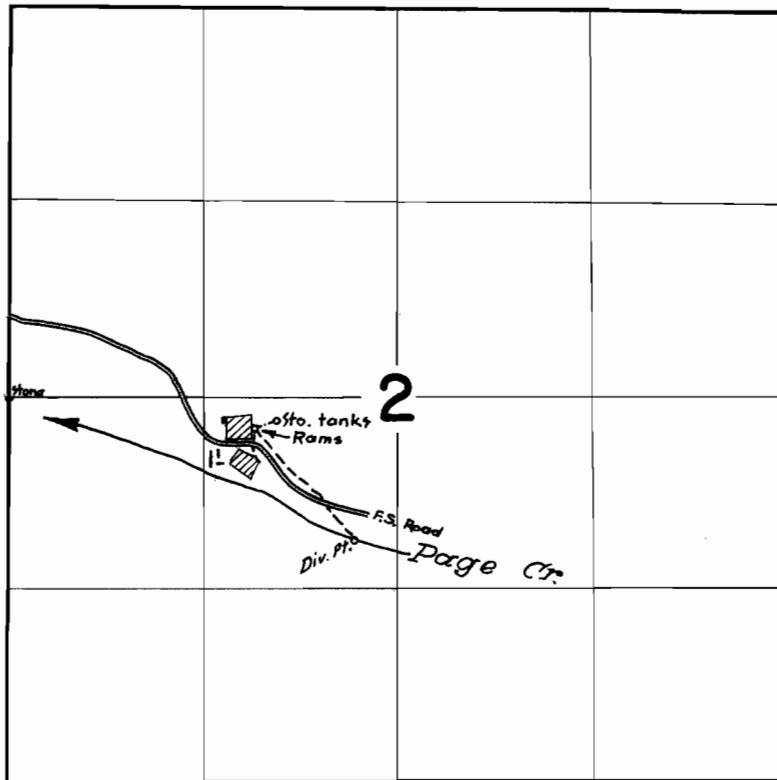

FINAL PROOF SURVEY
UNDER

Application No. 37707 Permit No. 28092
IN NAME OF

SISKIYOU NATIONAL FOREST

Surveyed July 15, 1963, by R. Peterson