


T.40S.R.8&9W.W.M.

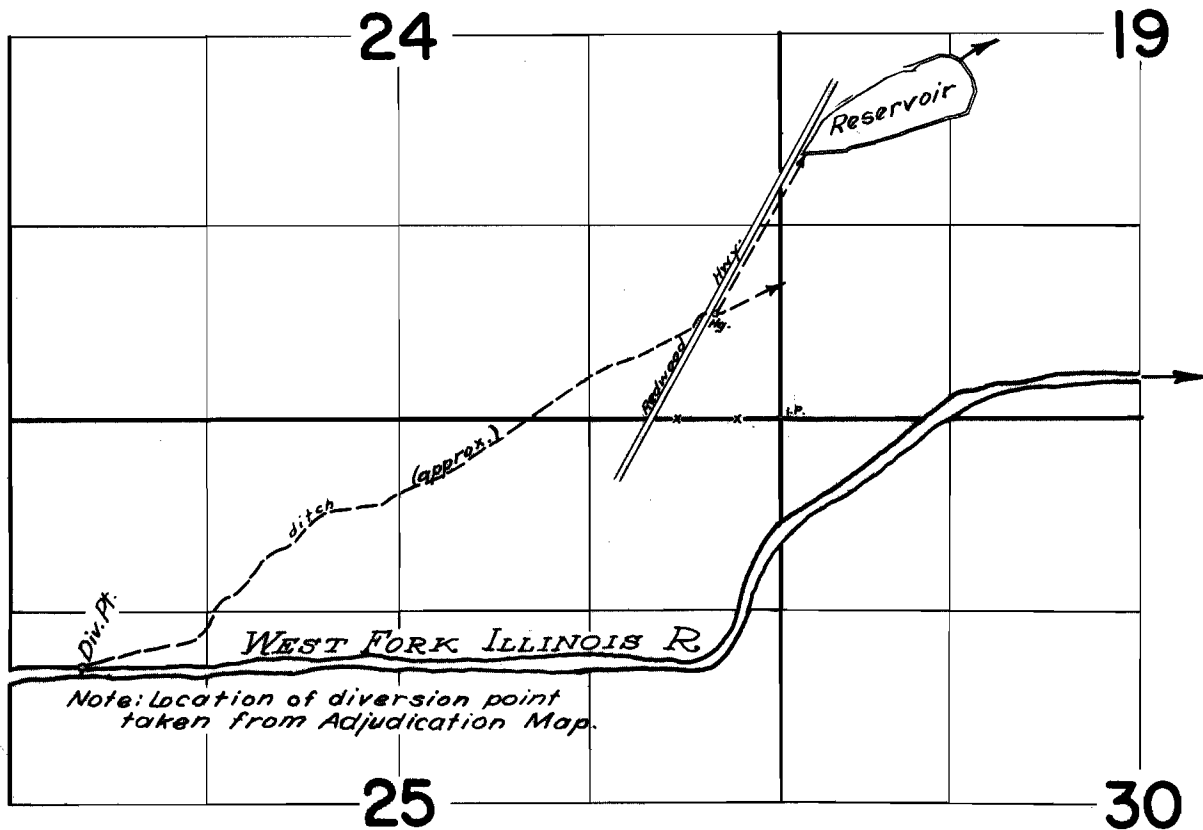

FINAL PROOF SURVEY
UNDER

R-37005 R-3150
Application No. 37248 Permit No. 28355
IN NAME OF

DELBERT O'BRIEN & CHARLIE A. TREFETHEN

Surveyed July 18, 1963, by *R. Jackson*