


T.18S.R.4W.W.M.

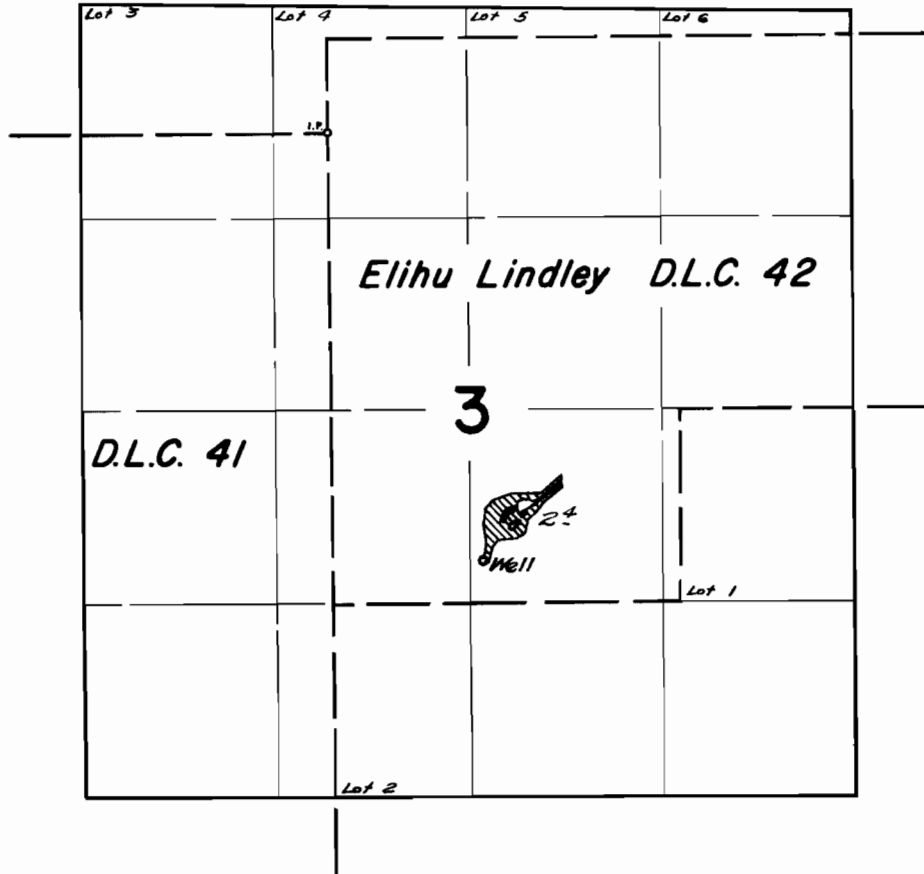

FINAL PROOF SURVEY
UNDER

Application No. G-928... Permit No. G-830...
IN NAME OF

NILS B. HULT

Surveyed June 25, 1963, by T. Lauer.....