


T. 15 S. R. 4 W. W.M.

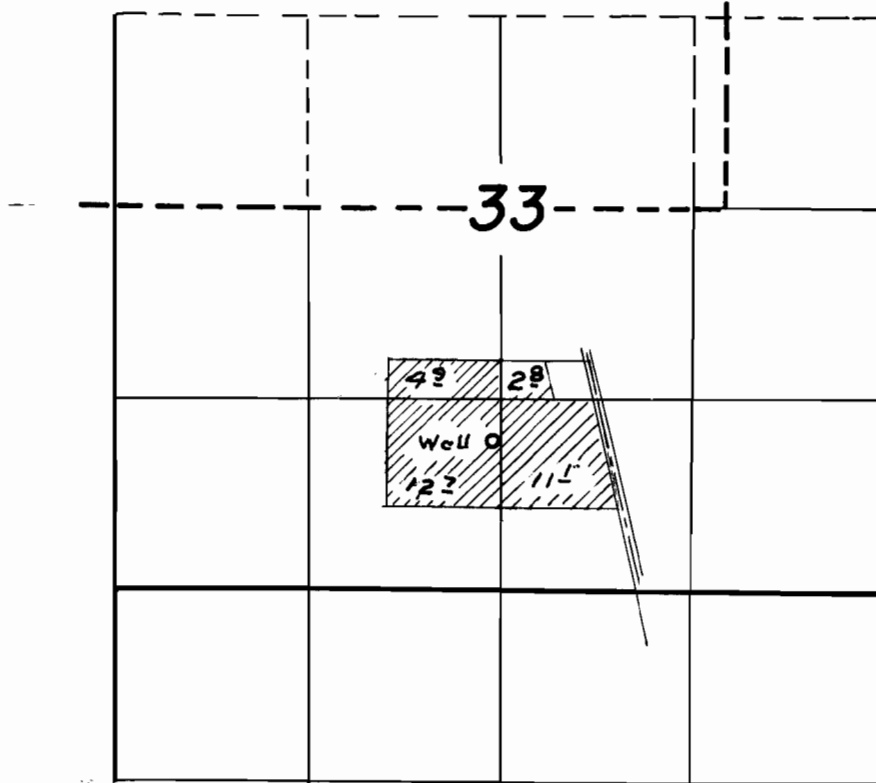

**FINAL PROOF SURVEY
UNDER**

Application No. G-2331 Permit No. G-2154
IN NAME OF

John F. Dieckhoff

Surveyed June 19, 1963, by T. Lauer