


**T. 18 S. R. 3 W. W. M.**

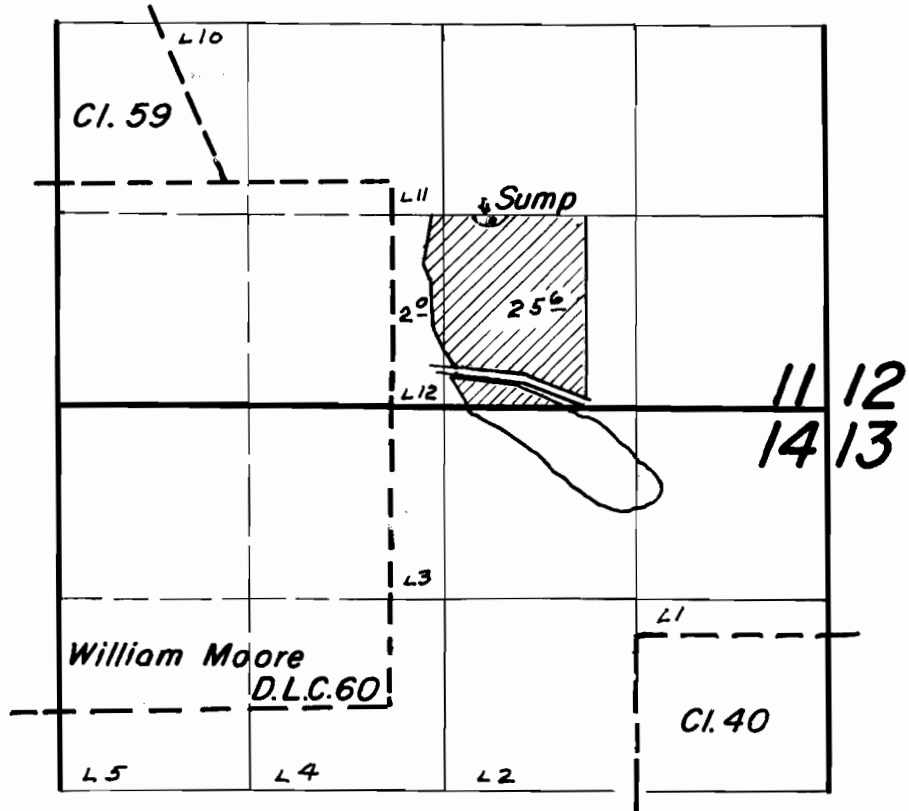

**FINAL PROOF SURVEY  
UNDER**

Application No. G-2399 Permit No. G-2193  
IN NAME OF

Robert W. Straub

Surveyed June 26 1963, by T. Laver