


T.18S.R.2W.W.M.

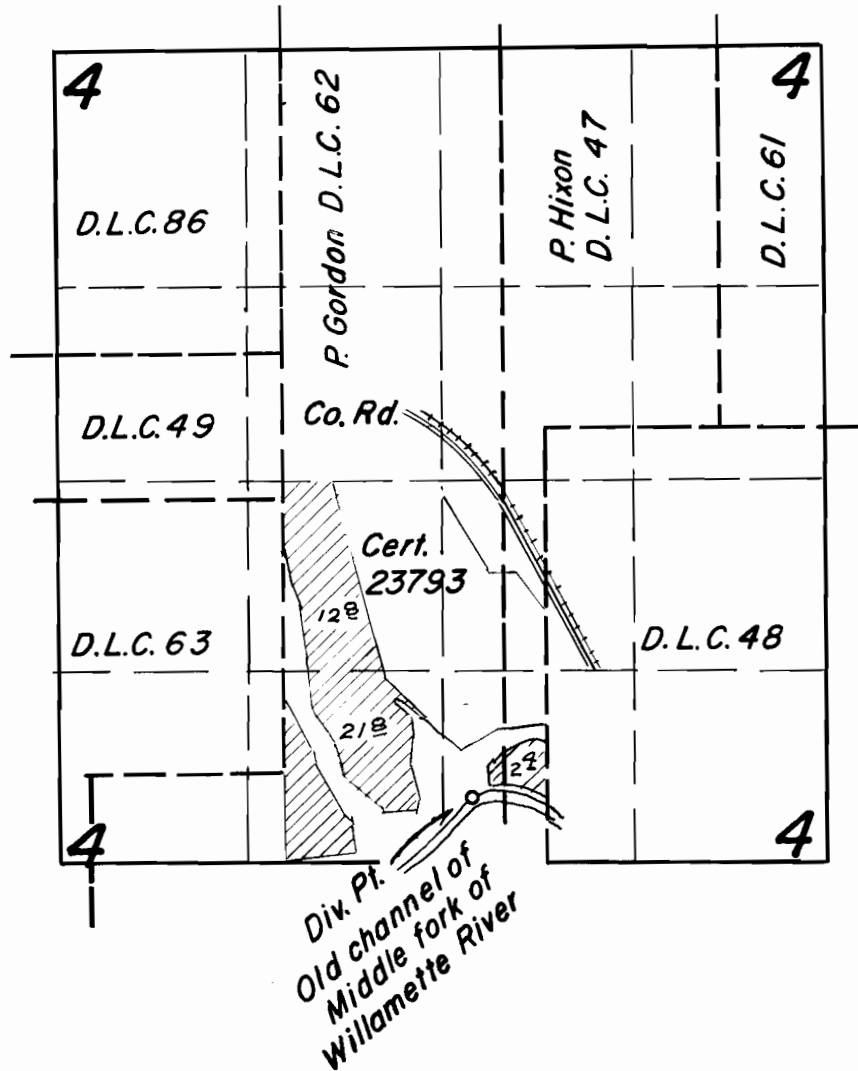

FINAL PROOF SURVEY
UNDER

Application No. 32169 Permit No. 25380
IN NAME OF

Lloyd F. Whiteaker & Truman A. Chase

Surveyed May 8 1963, by T. Lauer