


T. 16 & 17 S. R. 5 W. W. M.

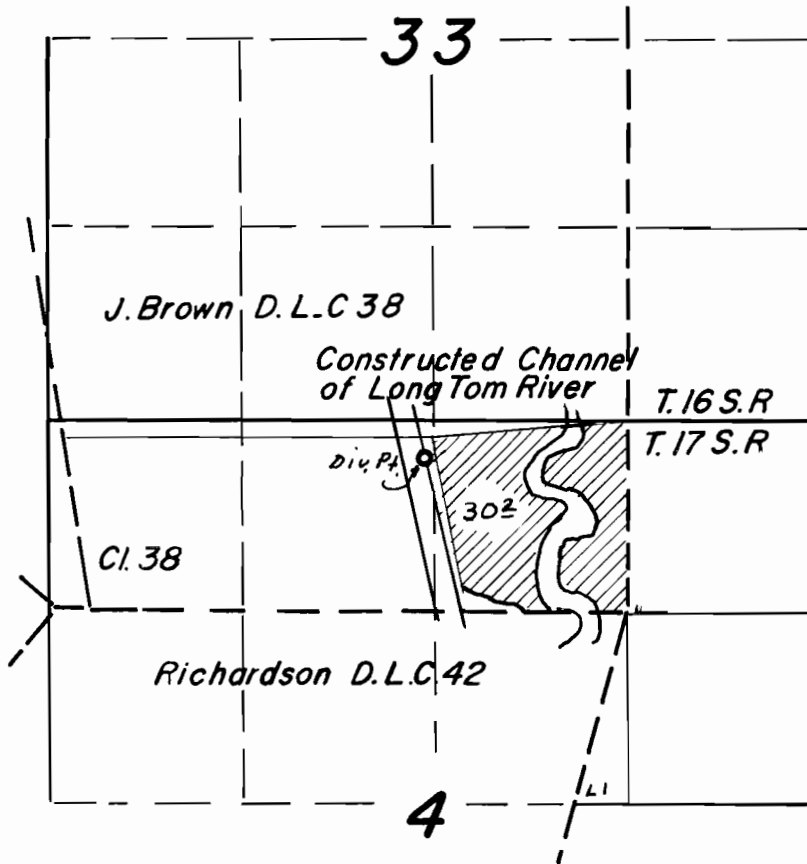

**FINAL PROOF SURVEY**  
UNDER

Application No. 32379 Permit No. 25568  
IN NAME OF

H.W. Haynes

Surveyed June 20 1963, by T. Lauer