


T.17S.R.5W.W.M.

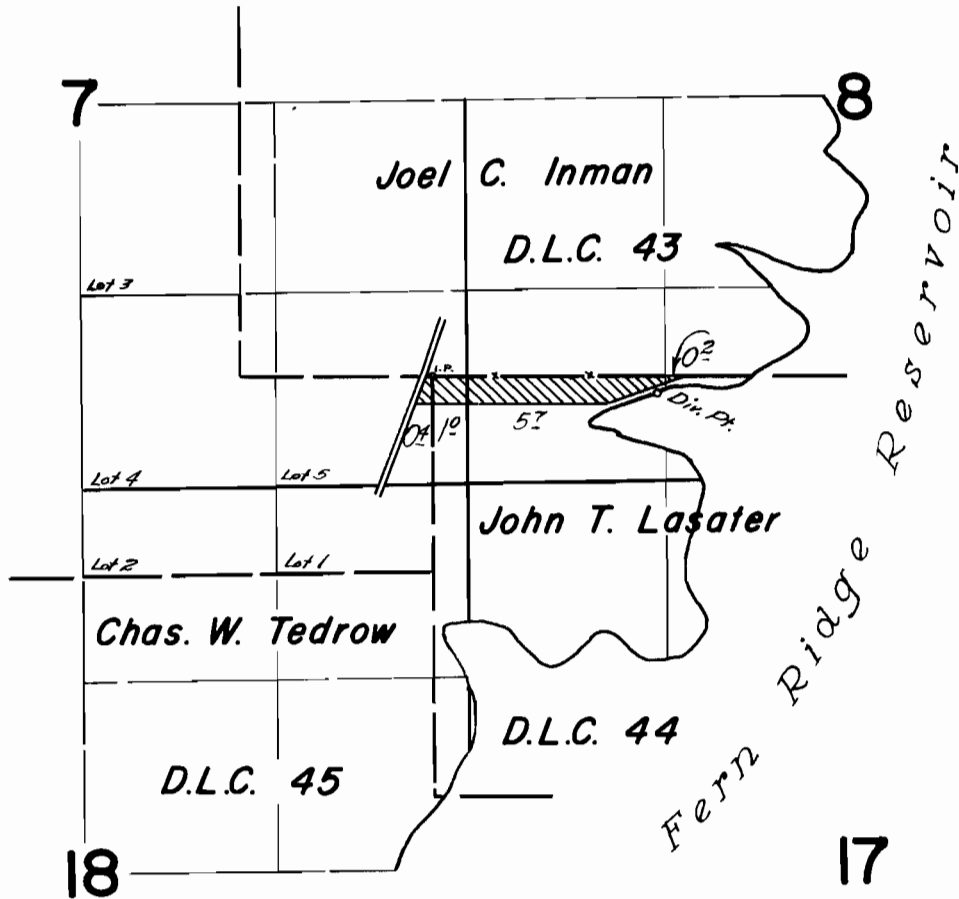

**FINAL PROOF SURVEY**  
UNDER

Application No. **32458** Permit No. **25765**  
IN NAME OF

**CARROL D. PARKINSON, M.D.**

Surveyed *May 9* 1963, by *Apperson*