


T. 21 S. R. 3 W. W. M.

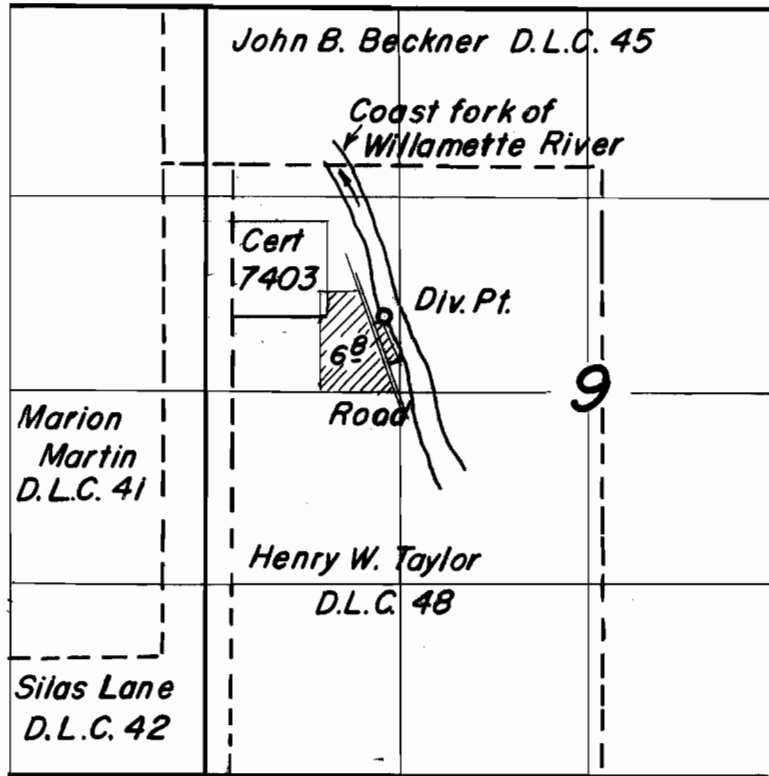

FINAL PROOF SURVEY
UNDER

Application No. 33705 Permit No. 26639
IN NAME OF

.....
Surveyed June 21, 1963, by C. Baker.....