


T.17S.R.4W.W.M.

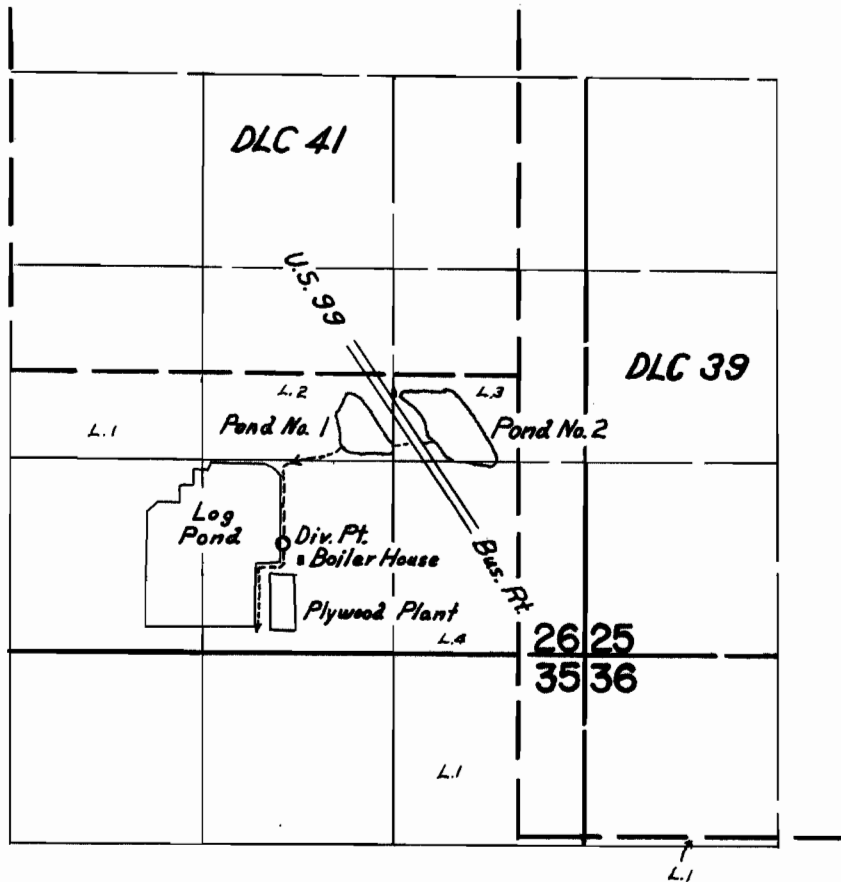

FINAL PROOF SURVEY UNDER

Application No. 33926 Permit No. 27050
IN NAME OF

Snellstrom Lumber Company

Surveyed May 10 1962, by Thomas R. Laurer