


T.18S. R. 2 & 3 W.W.M.

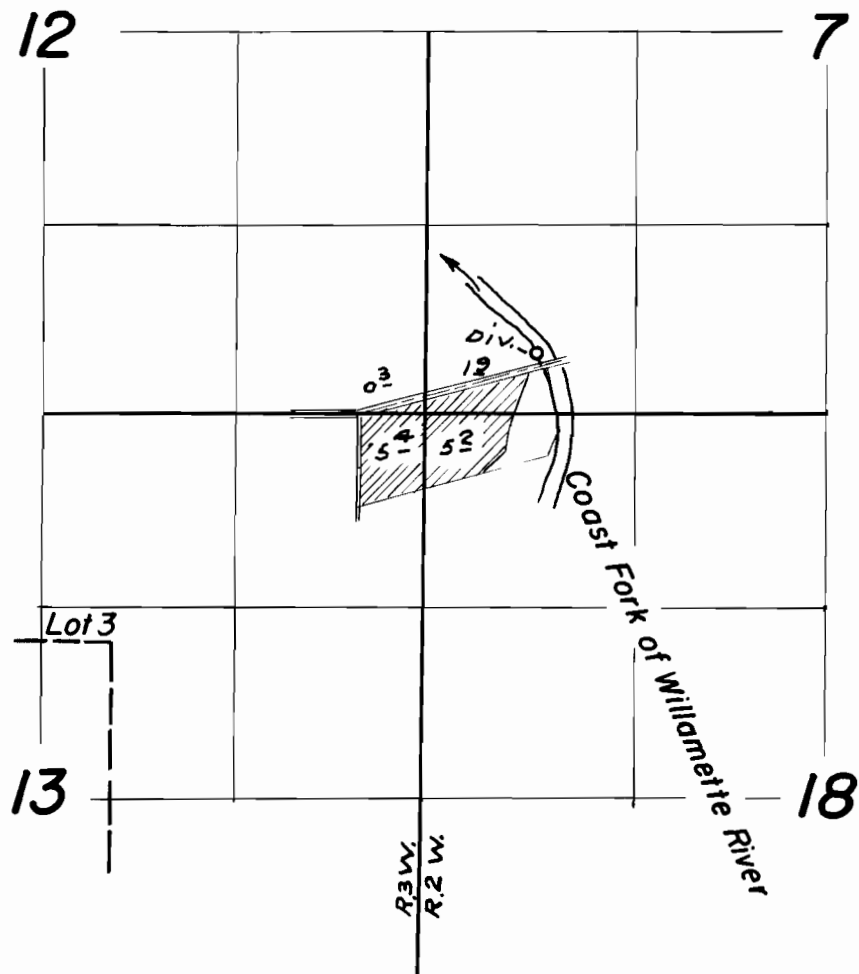

FINAL PROOF SURVEY
UNDER

Application No. 34639 Permit No. 27209
IN NAME OF

W. G. & Ina M. Saunders

Surveyed May 8 1963, by T. Lauer