


T.17S.R.1E.W.M.

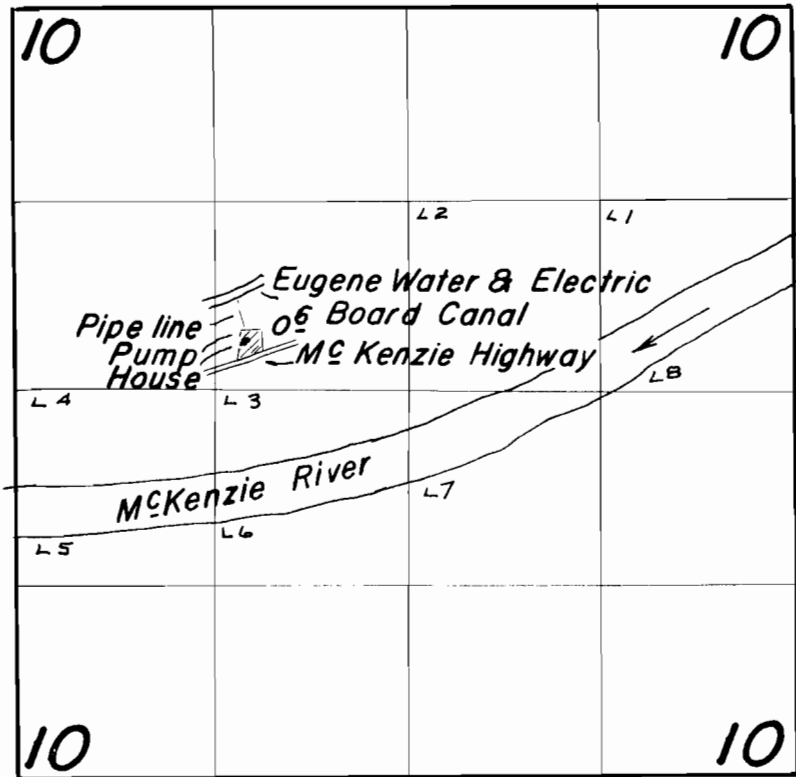

**FINAL PROOF SURVEY**  
UNDER

Application No. 37715 Permit No. 28095  
IN NAME OF

*George N. Easton*

Surveyed *June 18* 1963, by *C. Baker*