


T. 10 S. R. 4 W. W.M.

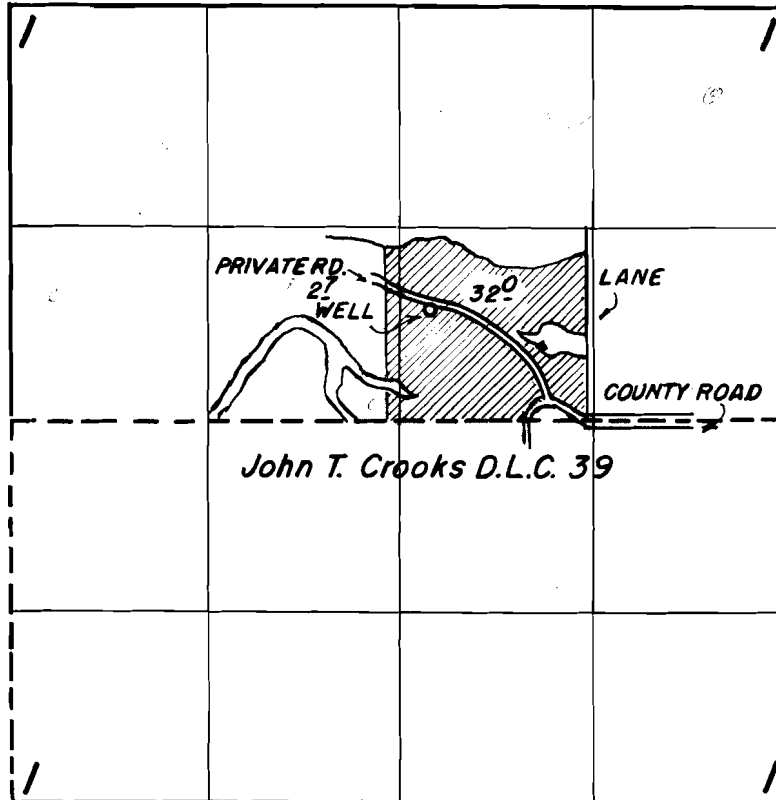

FINAL PROOF SURVEY
UNDER

Application No. G-1645 Permit No. G-1502
IN NAME OF

Florence M. Cooper

Surveyed Feb. 20, 1963, by Floyd L. Sigmond