


T.13S.R.1 E.W.M.

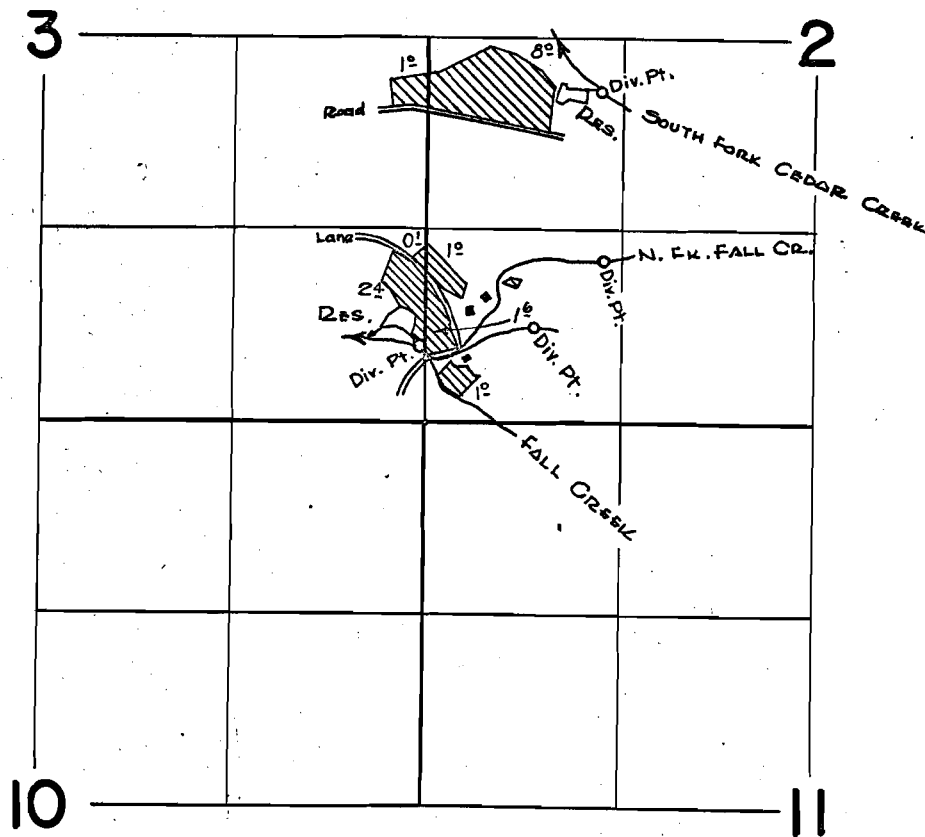

FINAL PROOF SURVEY

UNDER

Application No. 12-30486 Permit No. 12-1817
26935 23913
 IN NAME OF

MARTIN & MELVIN PICKENS

Surveyed Feb. 8, 1963, by F. L. SIGMUND