


T.13S.R.1E.W.M.

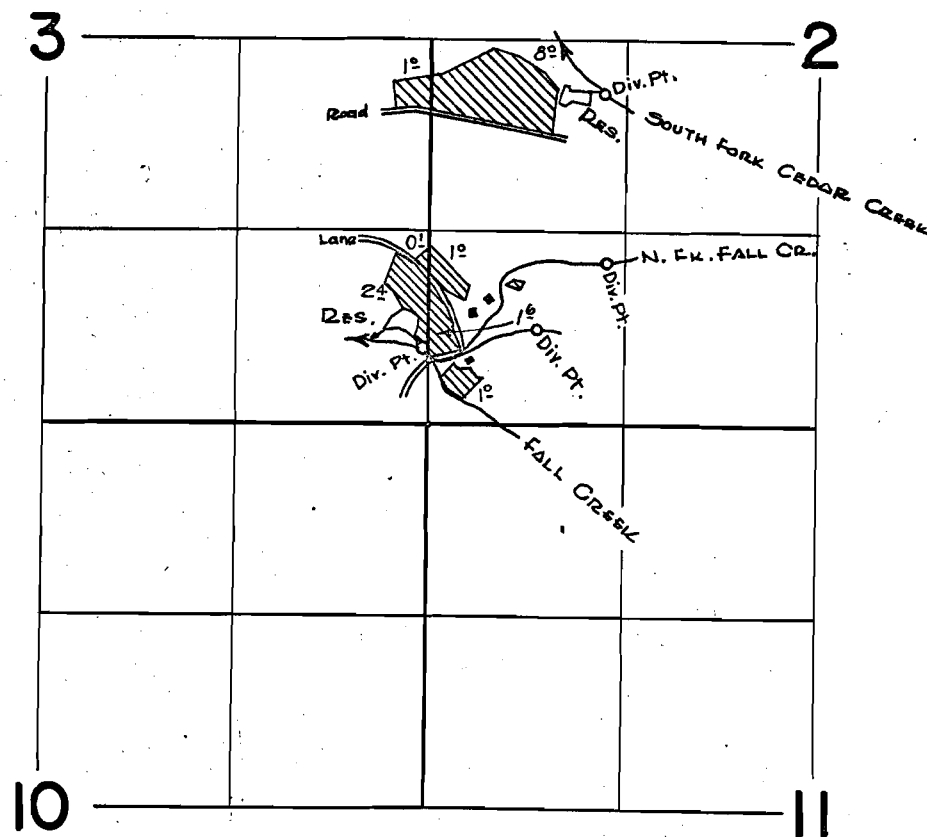

**FINAL PROOF SURVEY**  
UNDER

Application No. 12-30486 26935 Permit No. 12-1817 23913  
IN NAME OF

MARTIN & MELVIN PICKENS

Surveyed Feb. 8, 1963, by F. L. SIEGMUND