


T. 11 S. R. 4 W. W. M

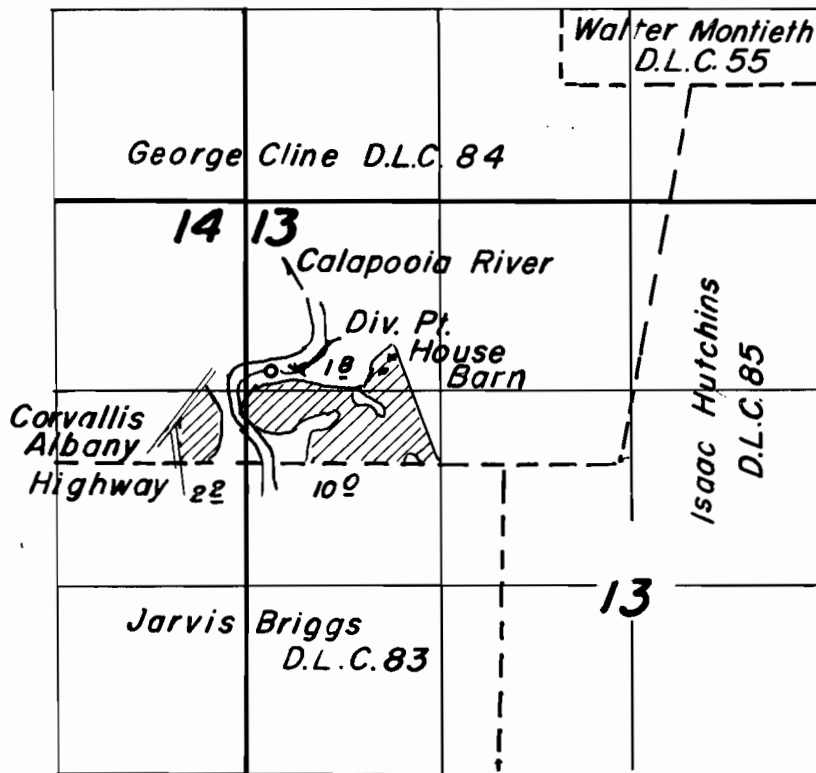

FINAL PROOF SURVEY  
UNDER

Application No. 34970 Permit No. 27425  
IN NAME OF

*Golda & Arville M. Perfect*

Surveyed March 21 1963, by *Gloyd L. Sigmund*