


T.19S.R.44E.W.M.

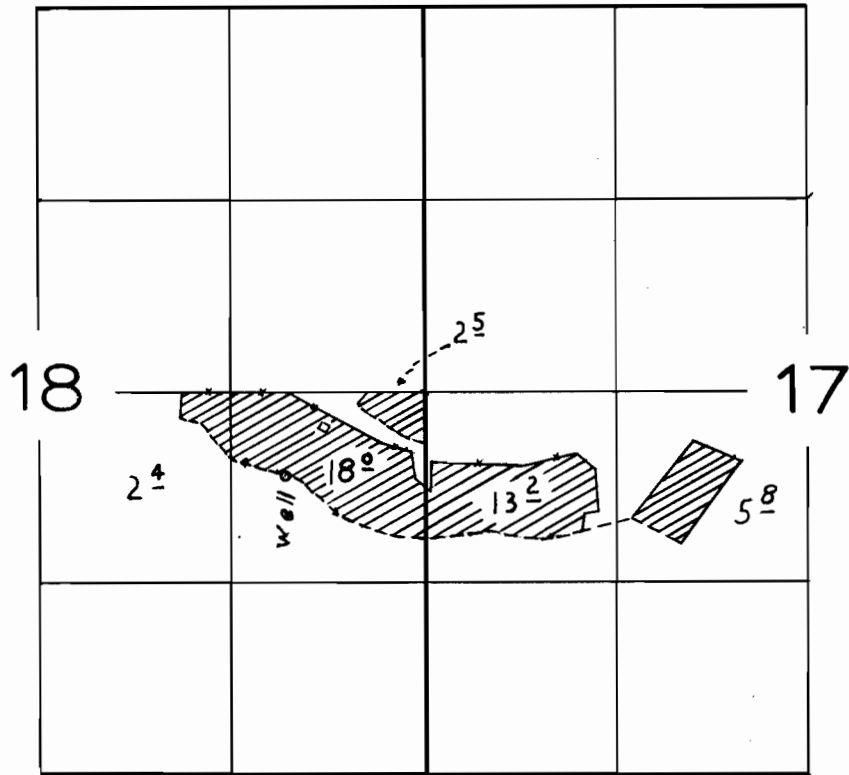

FINAL PROOF SURVEY
UNDER

Application No. G-1340 Permit No. G-1226
IN NAME OF

WARREN B. SCHLUPE

Surveyed November 12 1963, by F.W. Elfering