


T.5S.R.3W.W.M.

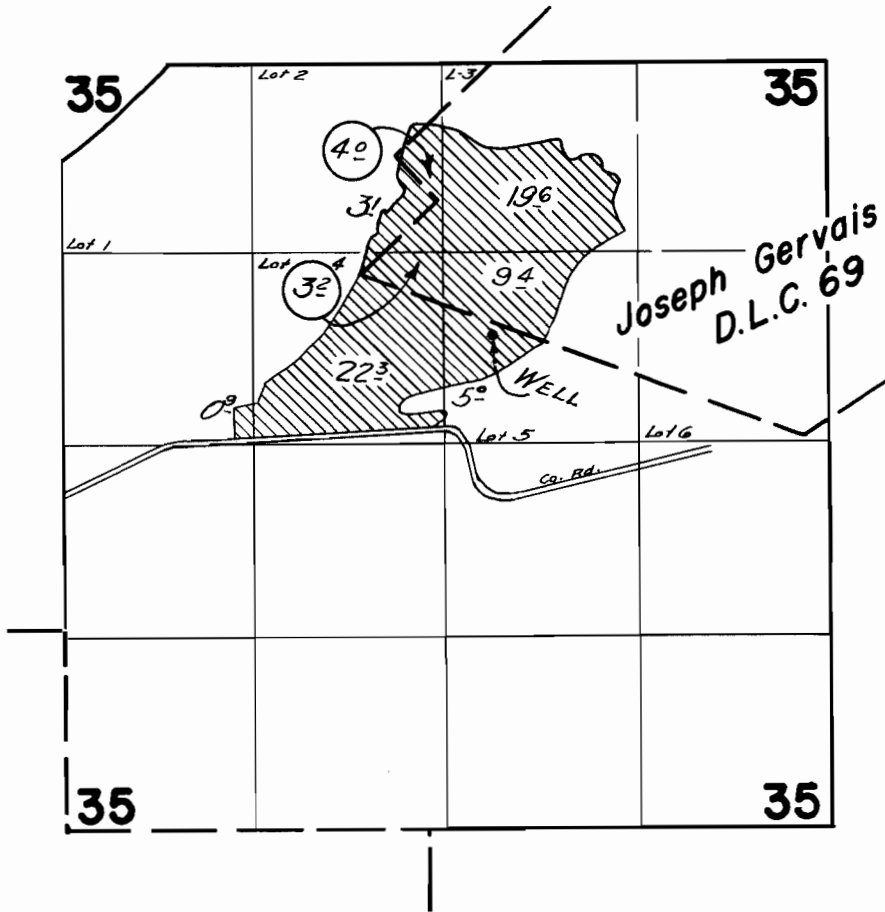

FINAL PROOF SURVEY
UNDER

Application No. G-621 Permit No. G-511
IN NAME OF

FRED VIESKO

Surveyed June 21, 1963, by R. Jackson