


T.9 S. R. 4 W. W.M.

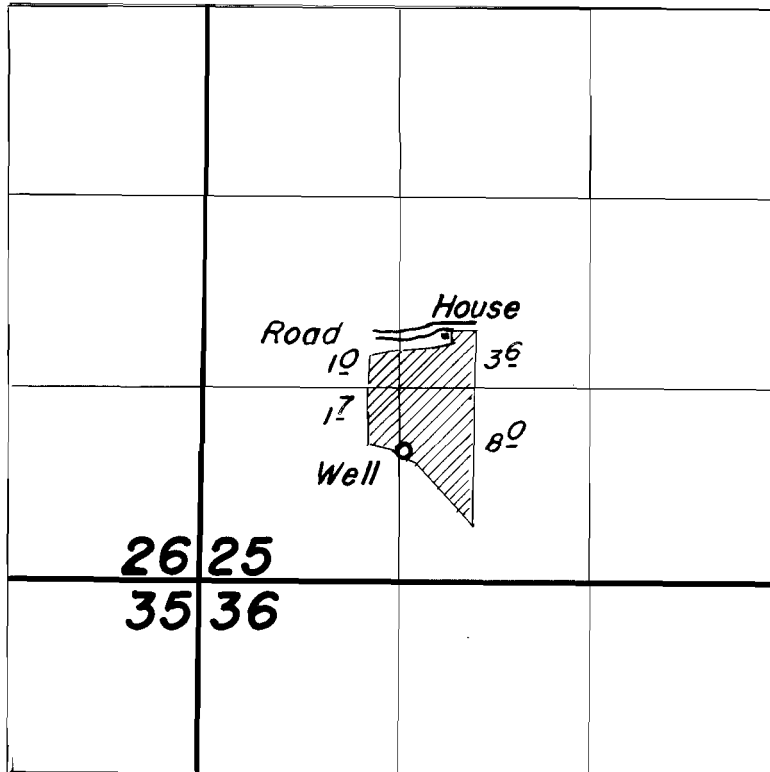

FINAL PROOF SURVEY
UNDER

Application No. G-1661 Permit No. G-1521
IN NAME OF

Gordon E. Turnidge

Surveyed July 23 1963, by Floyd L. Siegmund