


T. 8 S. R. 3 W. W.M.

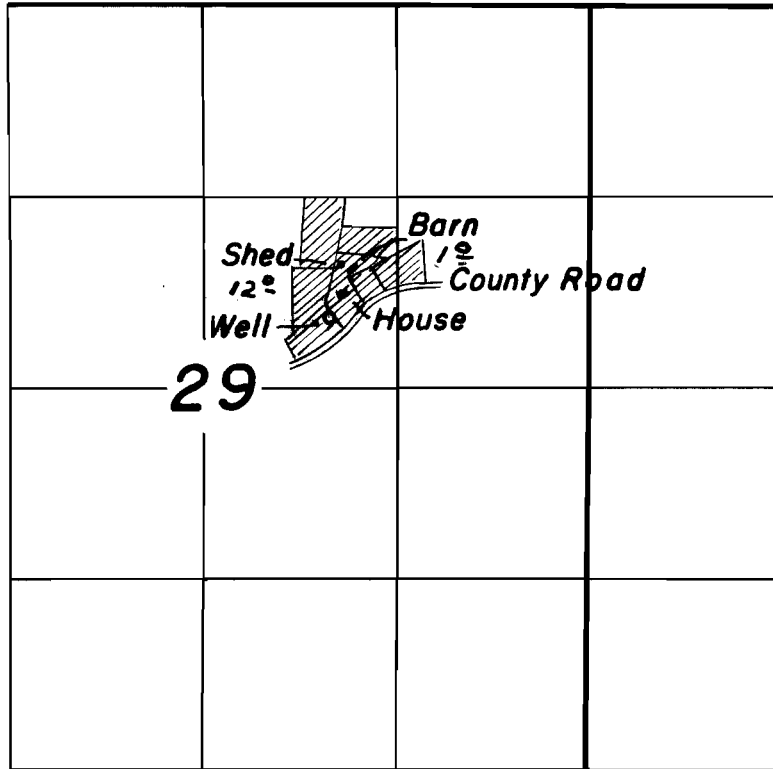

FINAL PROOF SURVEY
UNDER

Application No. G-1746 Permit No. G-1597
IN NAME OF

Estate of H.R. Jones & M.C. Jones

Surveyed July 2 1963 by Floyd L. Siegmund

2-1963-A