


T. 8 S. R. 3 W. W. M

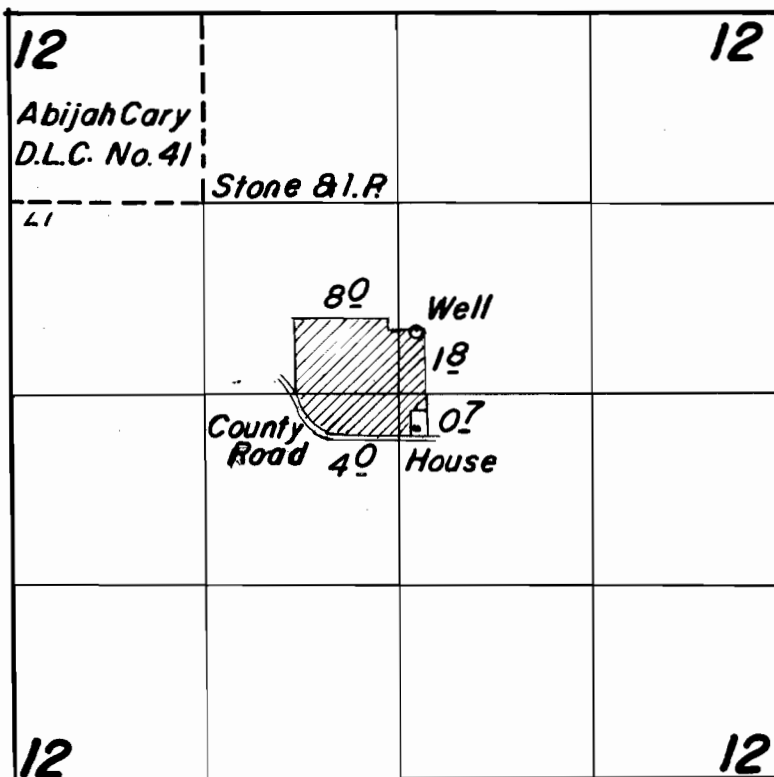

FINAL PROOF SURVEY
UNDER

Application No. G-2318 Permit No. G-2144
IN NAME OF

Jessie F. Boles

Surveyed July 3, 1963, by Floyd L. Siegmund