


T.4S.R.1W.W.M.

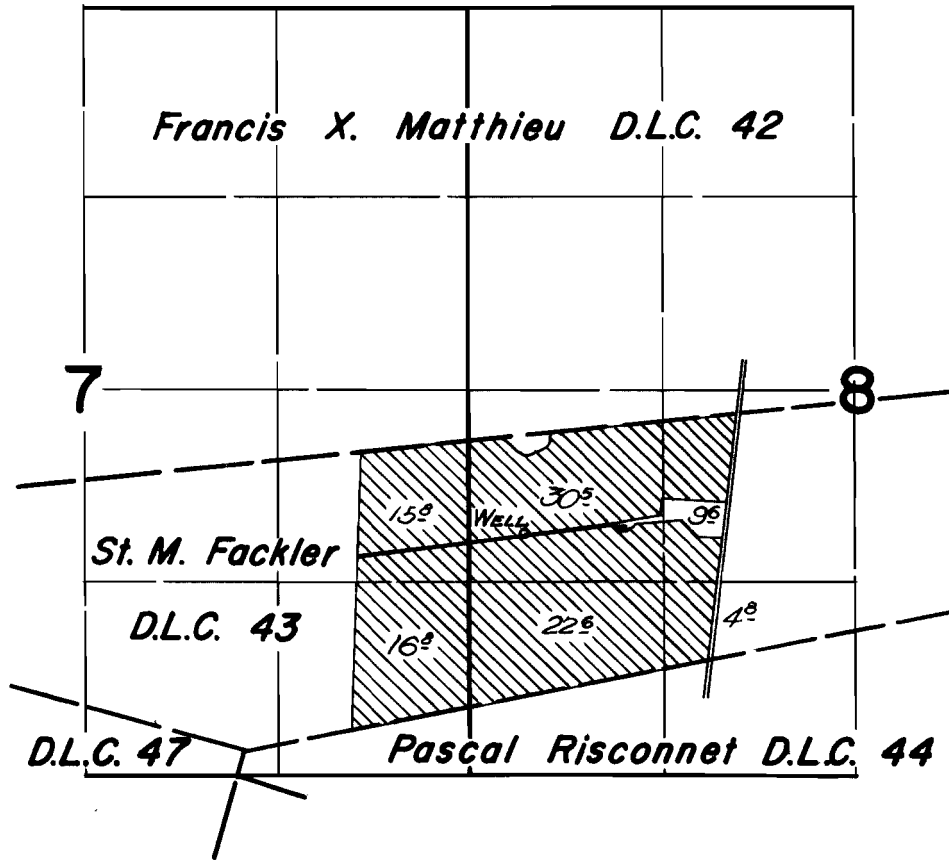

FINAL PROOF SURVEY UNDER

Application No. G-2319 Permit No. G-2145
IN NAME OF

PAUL E. SINGER

Surveyed June 19 1963, by *[Signature]*