


T. 6 S. R. 3 W. W. M.

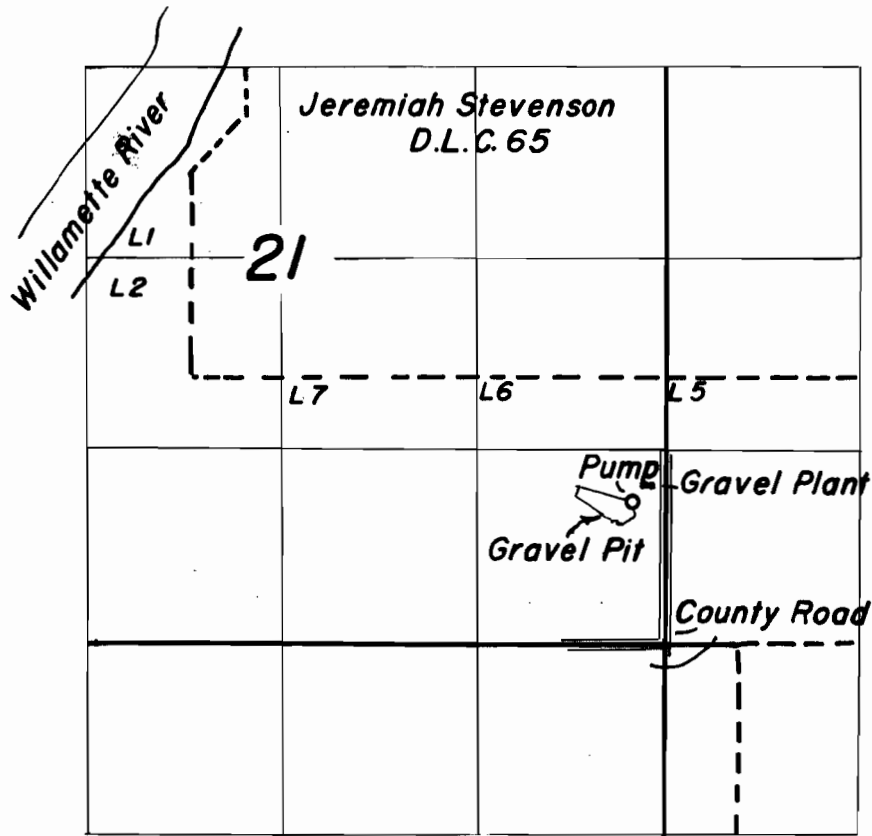

FINAL PROOF SURVEY
UNDER

Application No. G-2486 Permit No. G-2330
IN NAME OF

Howard A. Jones

Surveyed Sept. 9 1963, by Floyd L. Sigmund