


T. 9 S. R. 1 E. W. M.

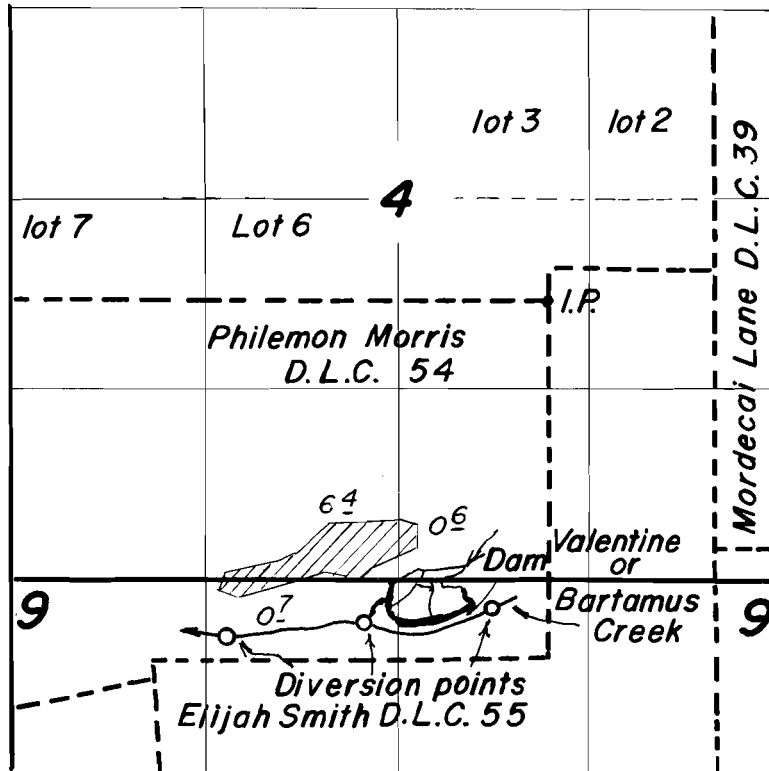

FINAL PROOF SURVEY
UNDER

32411 26047
Application No. R-32409 Permit No. R-2228
IN NAME OF

Ralph Siegmund

Surveyed JULY 12 1963, by Floyd L. Siegmund