


T. 6 S. R. 2 W. W. M.

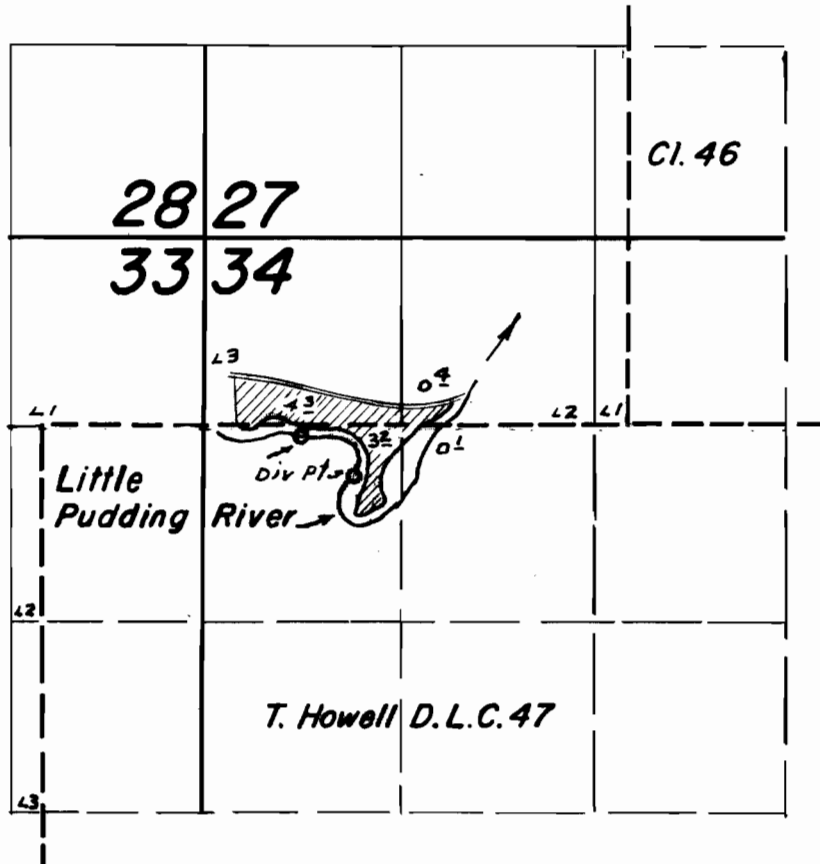

FINAL PROOF SURVEY
UNDER

Application No. 34395 Permit No. 27023
IN NAME OF

Arthur F. Schoenborn

Surveyed Nov. 13 1963, by F. Siegmund