


T.6S.R.2W.W.M.

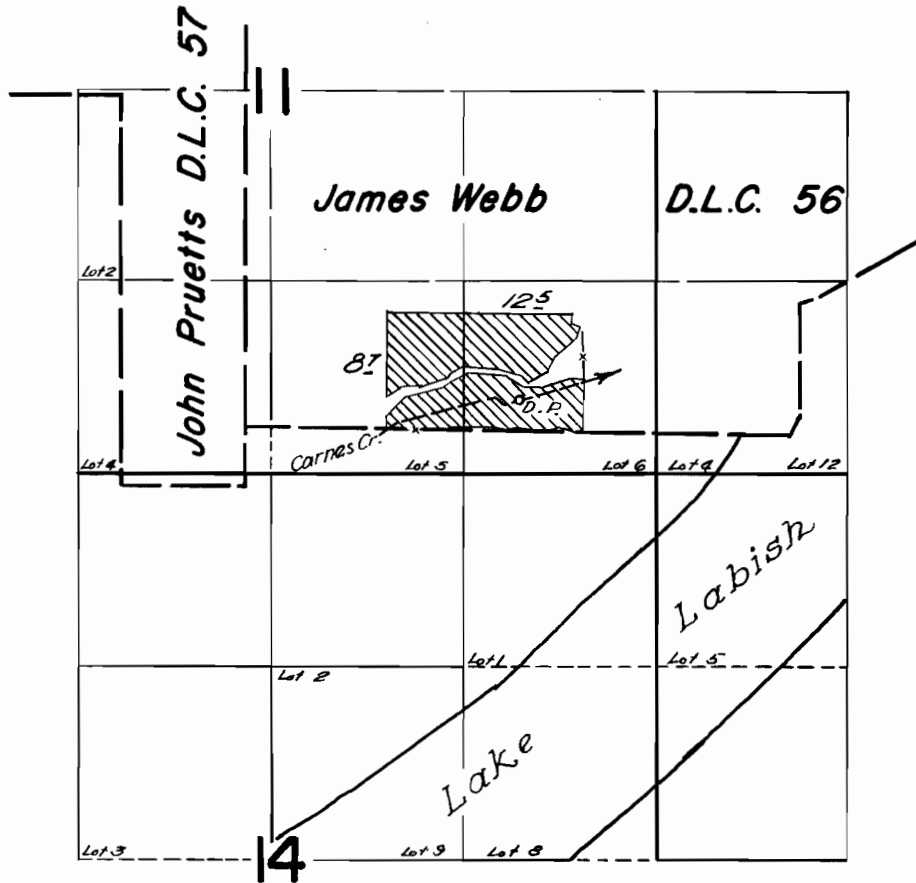

FINAL PROOF SURVEY
UNDER

Application No. 35661 Permit No. 27506
IN NAME OF

CLYDE REED

Surveyed August 2 1963, by [Signature]