


T.6S.R.2W.W.M.

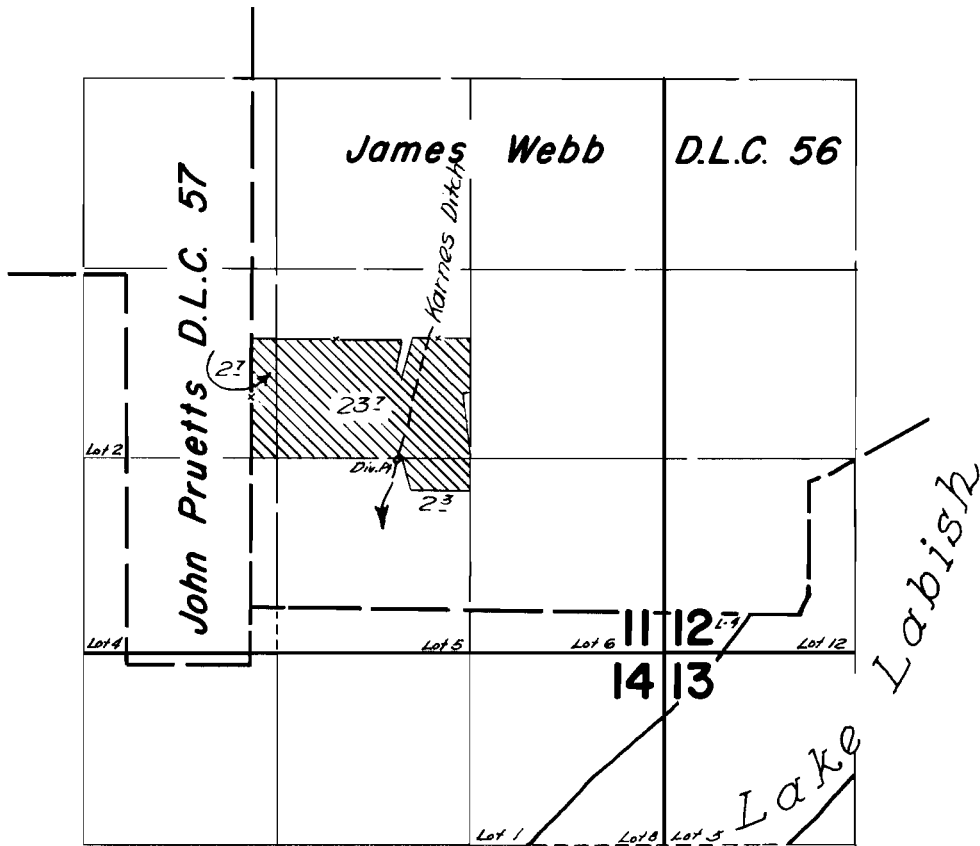

**FINAL PROOF SURVEY**  
UNDER

Application No. **38025** Permit No. **28340**  
IN NAME OF

**THOMAS J. PFAU**

Surveyed *August 1* 1963, by *R. Jackson*