


**T.6 S.R.6 W.W.M.**

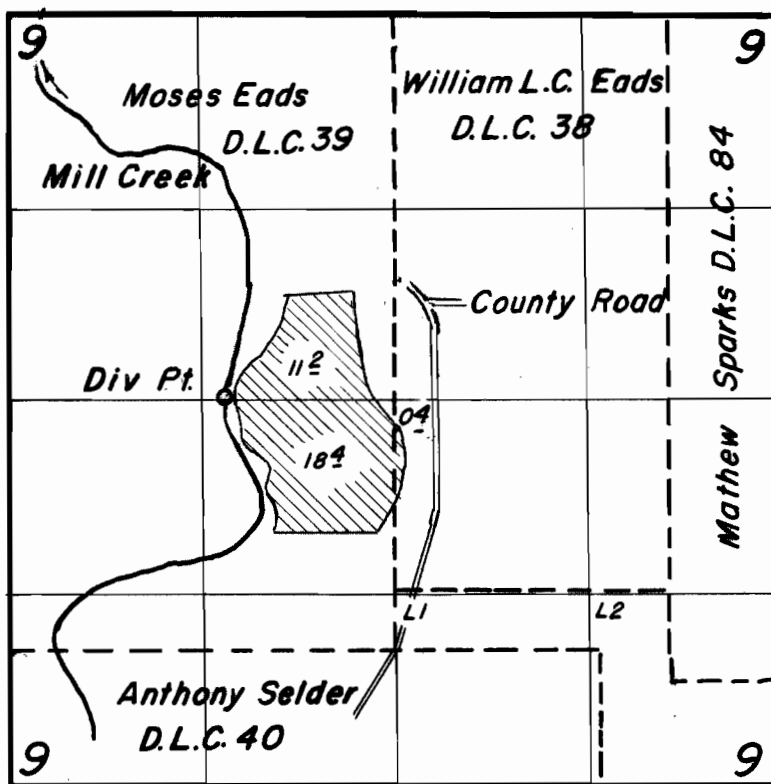

**FINAL PROOF SURVEY**  
UNDER

Application No. 33532 Permit No. 26520  
IN NAME OF

Hugh Veach

Surveyed March 6 1963, by Floyd L. Siegmund