


T.6S.R.8W.W.M.

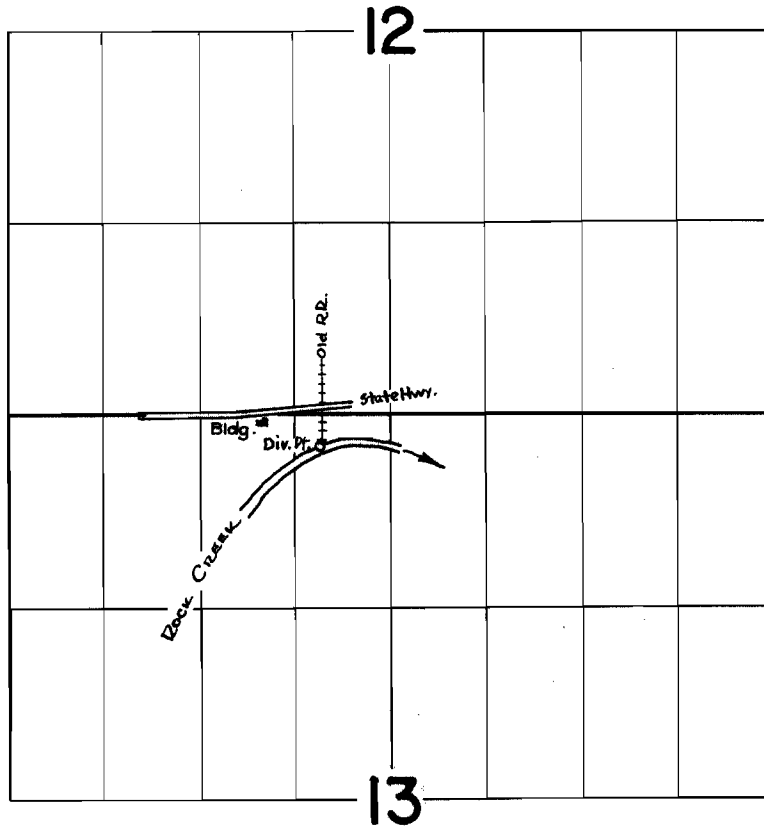

FINAL PROOF SURVEY
UNDER

Application No. 33760 Permit No. 26602
IN NAME OF

.....
Surveyed Nov. 13 1963, by F. L. SIGMUND

RJ