


T. 6 S. R. 3 W. W. M.

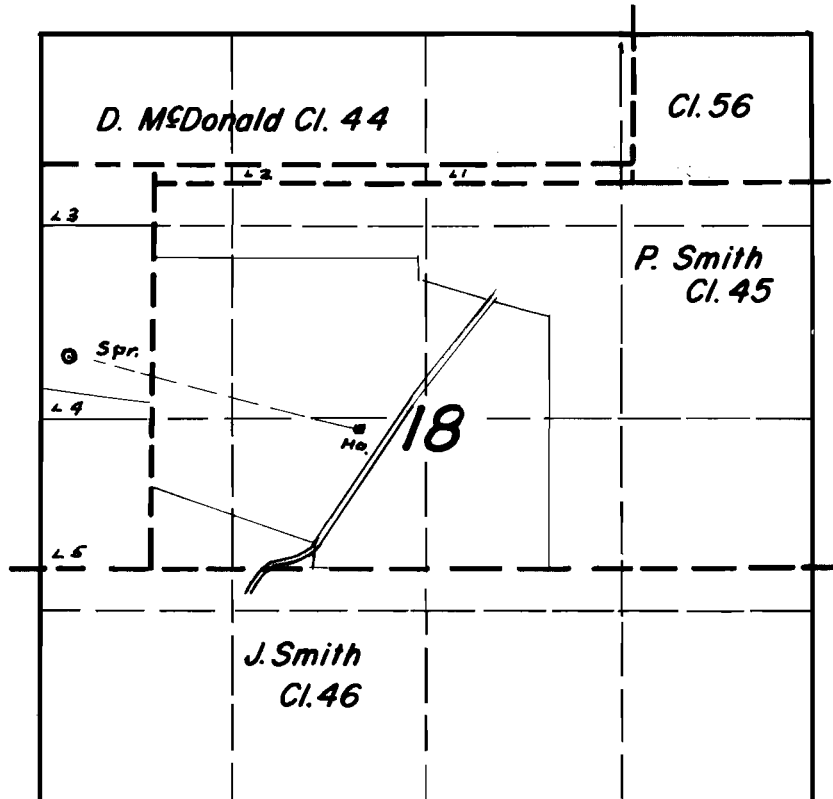

FINAL PROOF SURVEY
UNDER

Application No. 38245 Permit No. 28503
IN NAME OF

Grace M^c Kinney

Surveyed Nov. 13 1963, by F. Siegmund