


T.2S.R.10&11W.W.M.

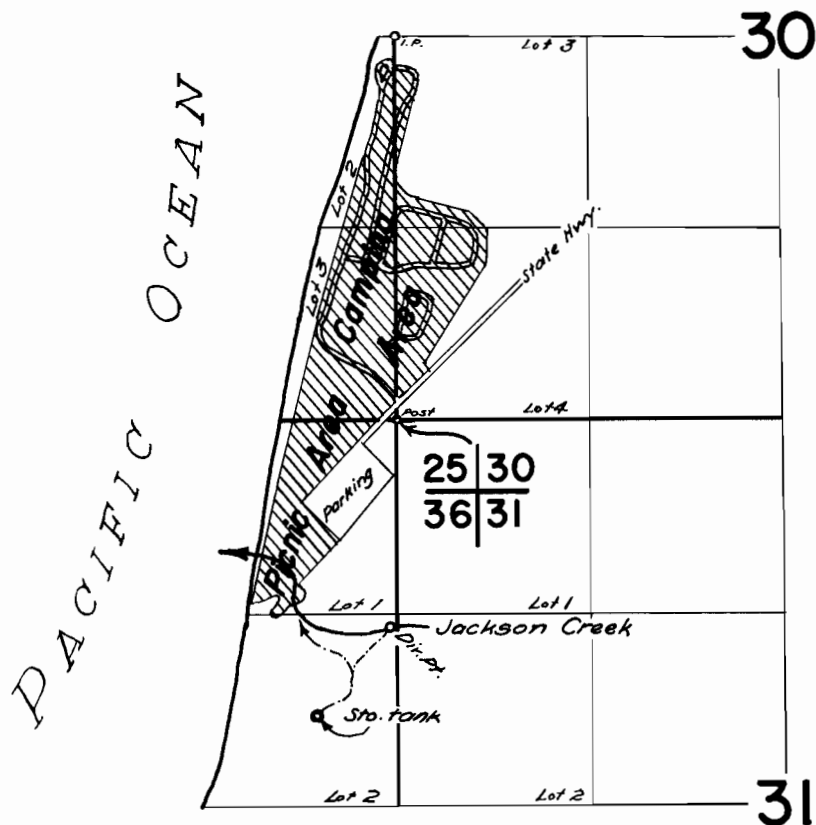

FINAL PROOF SURVEY
UNDER

Application No. **19063** Permit No. **18861**
IN NAME OF

Parks Dept. of the Oregon State Highway Commission

Surveyed July 25 1963, by *R. Jackson*