


T. 1 S. R. 9 & 10 W. W. M.

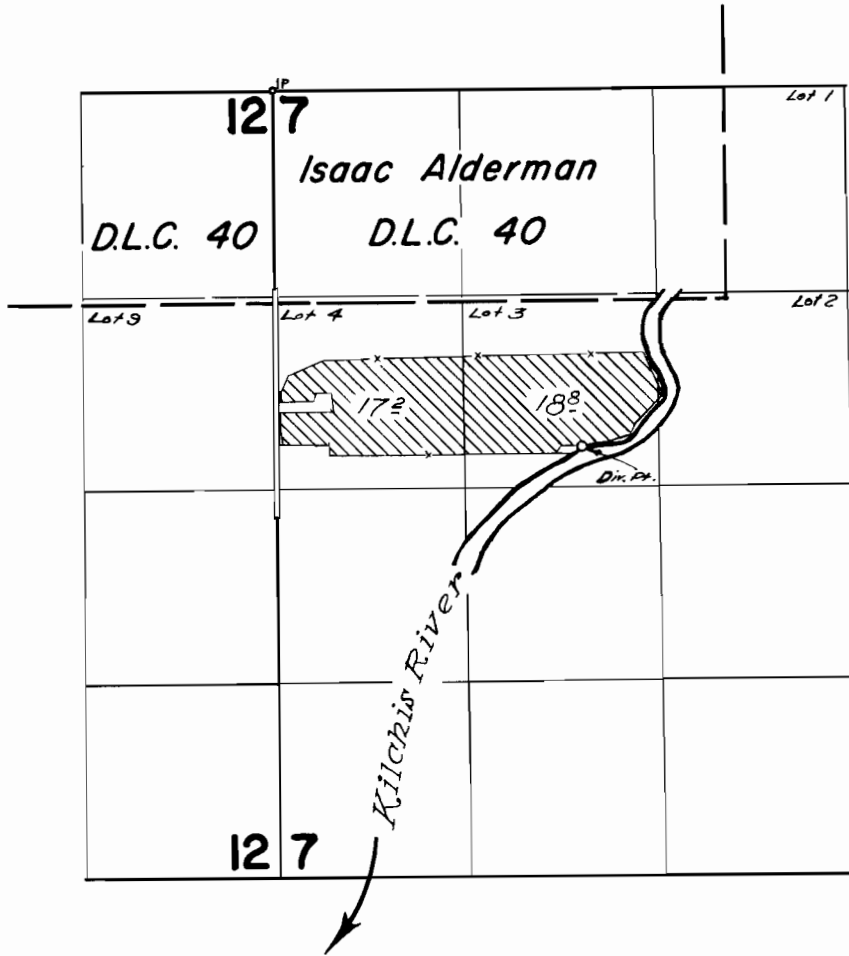

FINAL PROOF SURVEY
UNDER

Application No. 34250 ... Permit No. 26962
IN NAME OF

ALBERT E. MAYER

Surveyed July 22 1963, by *R. A. Johnson*