


T. 1 S. R. 9 W. W. M.

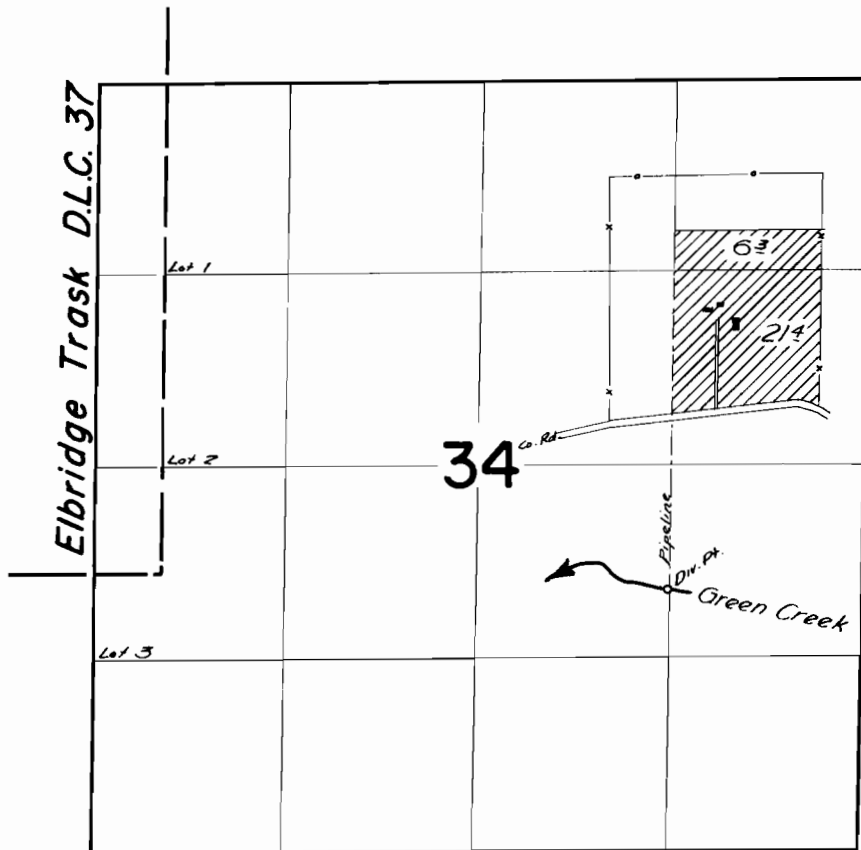

FINAL PROOF SURVEY UNDER

Application No. 37027 Permit No. 27597
IN NAME OF

HARVEY A. WYSS

Surveyed July 24, 1963, by *A. Jackson*