


T.6N.R.34&35E.W.M.

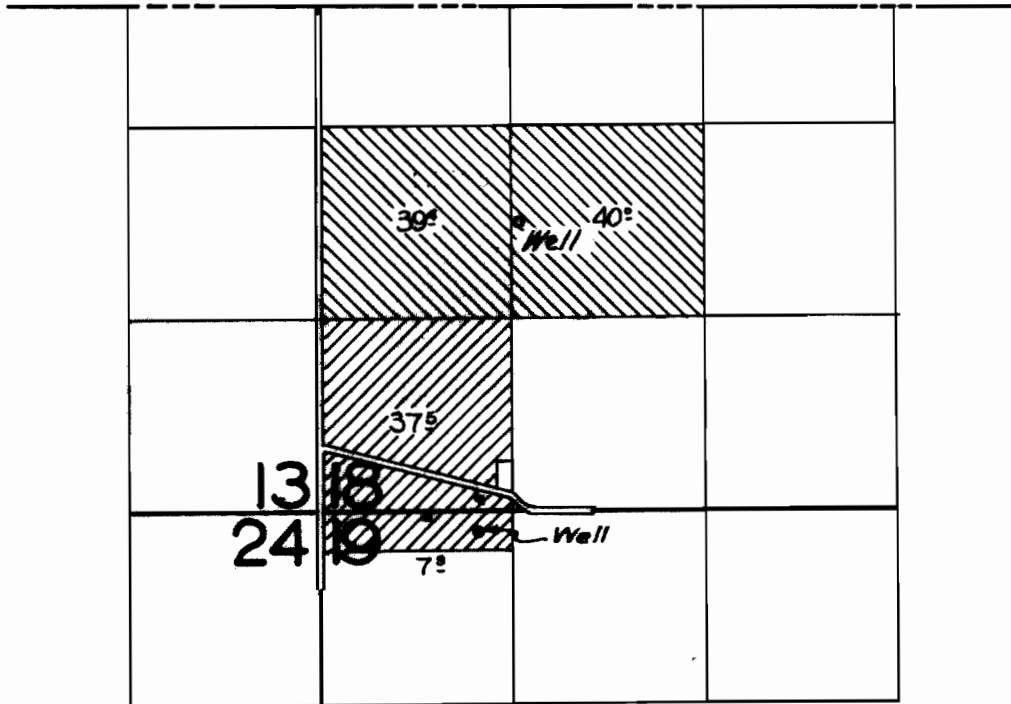

FINAL PROOF SURVEY
UNDER

Application No. G-1264 Permit No. G-1158
G-1265 Permit No. G-1159
IN NAME OF

AL & PEARL BEARD

Surveyed May 1 1962, by R. Jackson