


T.6N.R.35-36E.W.M.

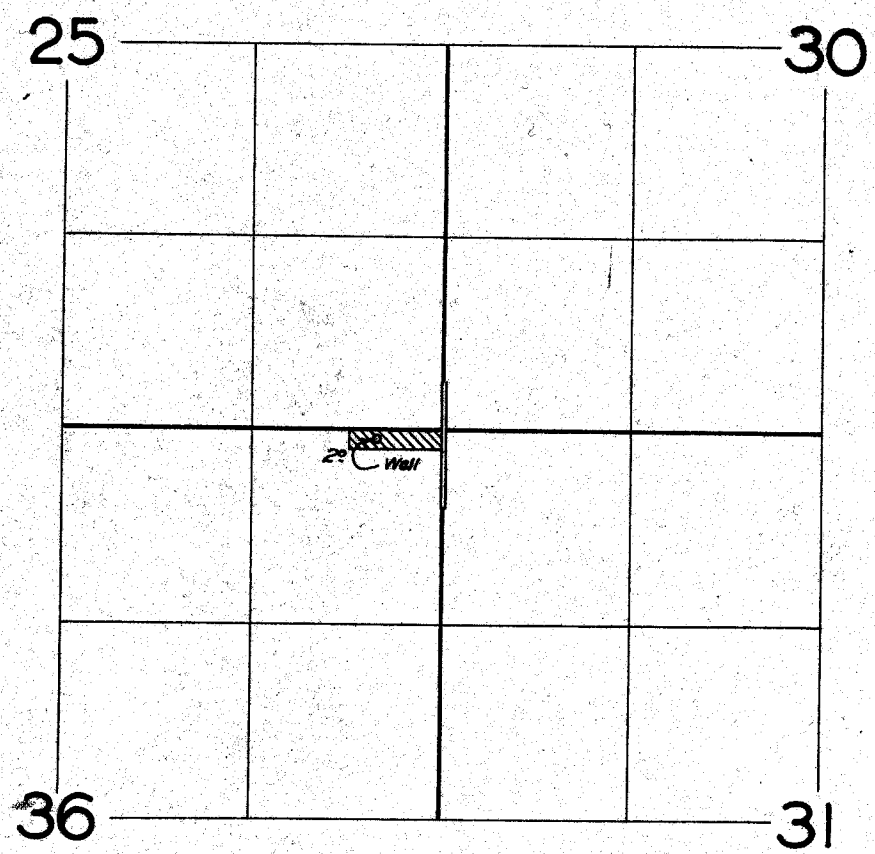

FINAL PROOF SURVEY UNDER

Application No. G-1435 Permit No. G-1302
IN NAME OF

FRANK E. HODGE

Surveyed April 24 1962, by Alpeben