


T.6S.R.39E.W.M.

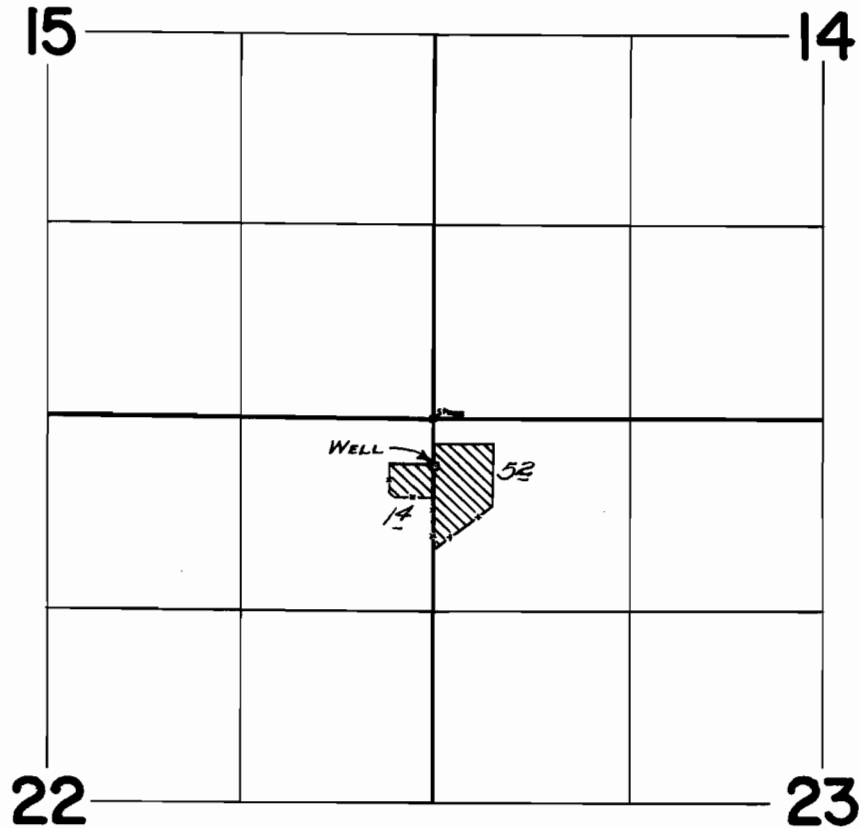

FINAL PROOF SURVEY UNDER

Application No. G-1157... Permit No. G-1153...
IN NAME OF

North Powder...Cemetery...Maintenance...Dist.

Surveyed Sept. 27, 1963, by C.R. Baker...

PK