


T.3S.R.38E.W.M.

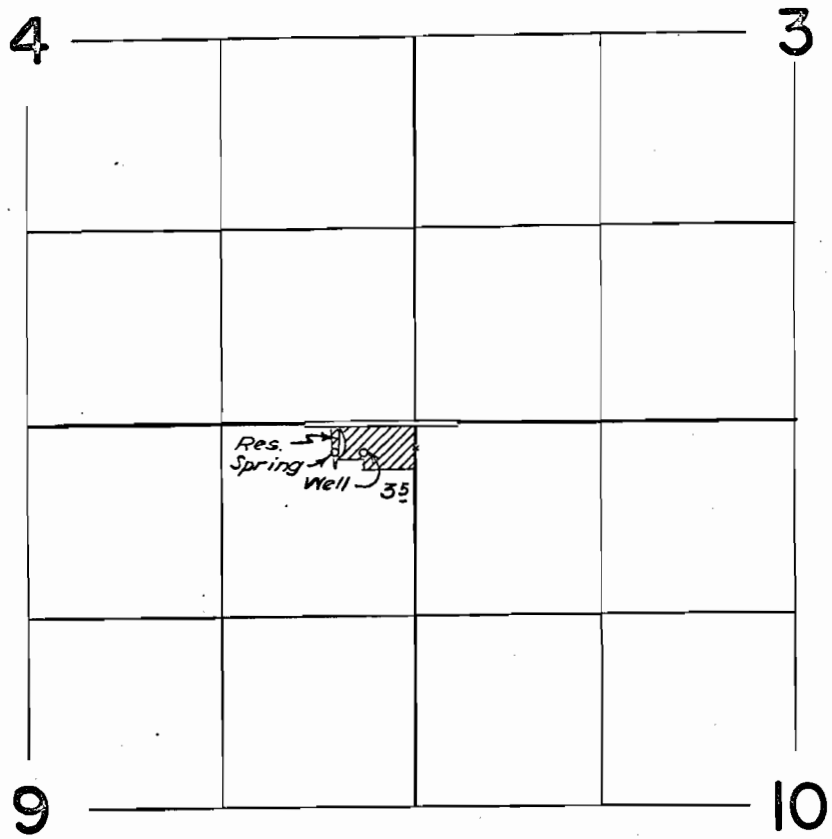

FINAL PROOF SURVEY  
UNDER

G-1855                      G-1697  
R-34437                     R-2581  
Application No. 34584... Permit No. 27160....  
IN NAME OF

ROY H. & JUNE BYRON

Surveyed Oct. 2... 1963, by C.R. Baker...