


T.6S.R.38E.W.M.

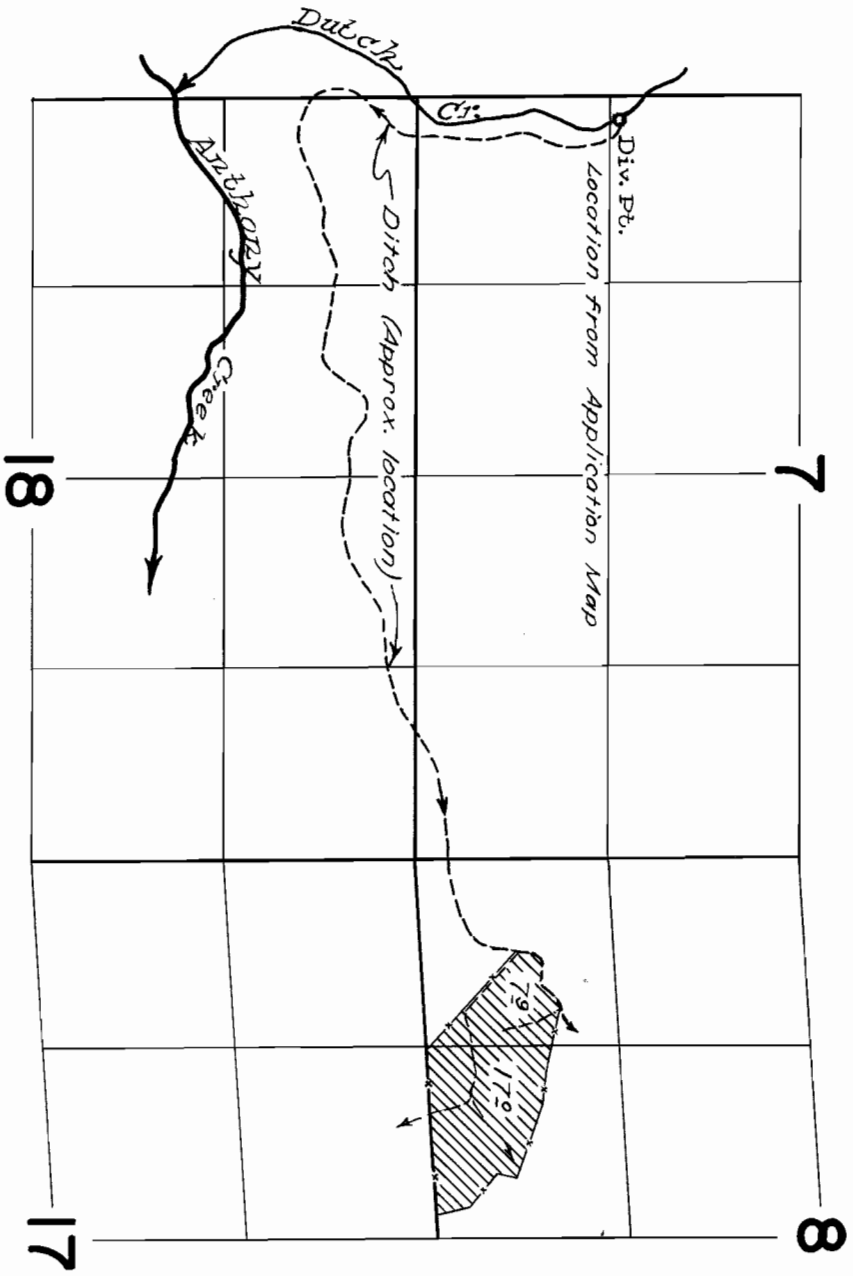


FINAL PROOF SURVEY UNDER

Application No. 31370 Permit No. 24734
IN NAME OF

MARY K. CHRISTMAN

Surveyed Sept. 27 1963, by C. R. Baker

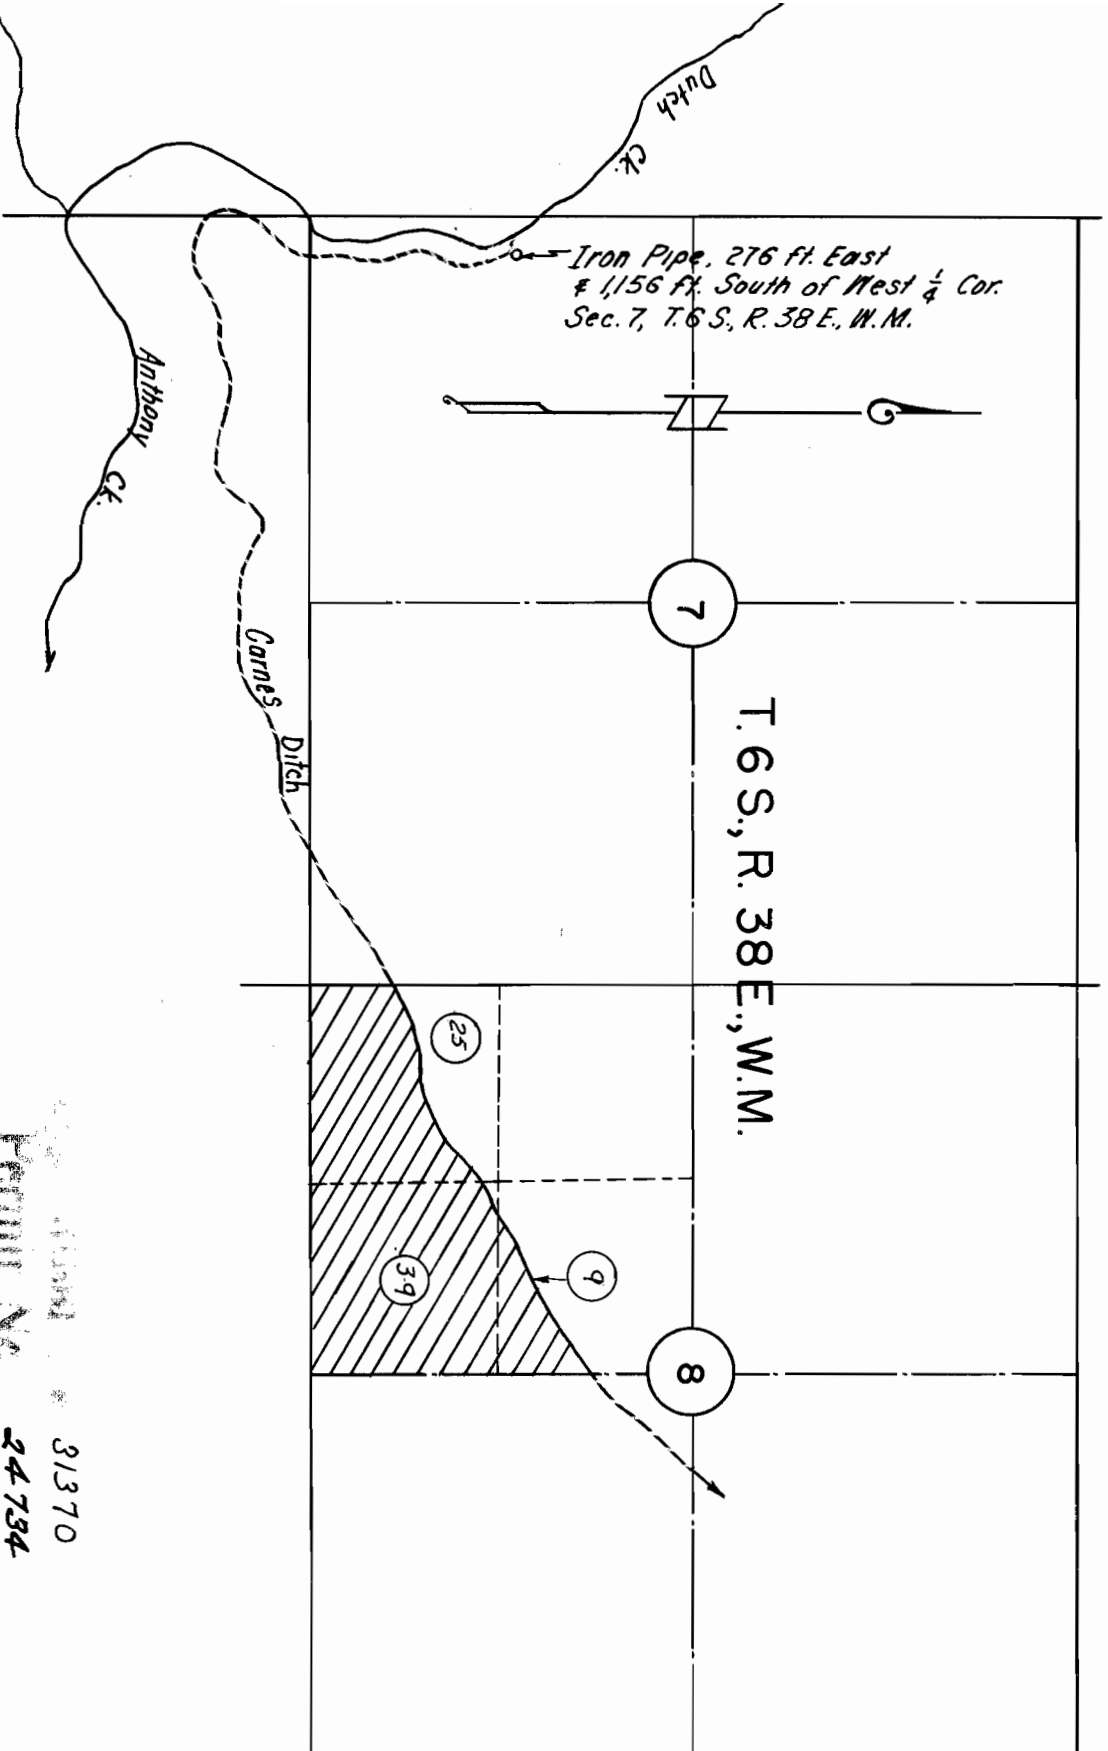

I, James D. Hanley, of Baker, Oregon do hereby certify that this map was made from notes taken during an actual survey made by me on January 9, 1957 and from an aerial photograph; that the monument shown on this map, consisting of an iron pipe 1"x36", 30" in the ground, is 276 feet East and 1,156 feet South of West 1/4 Corner of Sec. 7, T. 6 S., R. 38 E., W.M.



Permit No. 24734

MAP TO ACCOMPANY APPLICATION FOR WATER PERMIT

Scale: 4" = 1 Mile