


T.3S.R.40E.W.M.

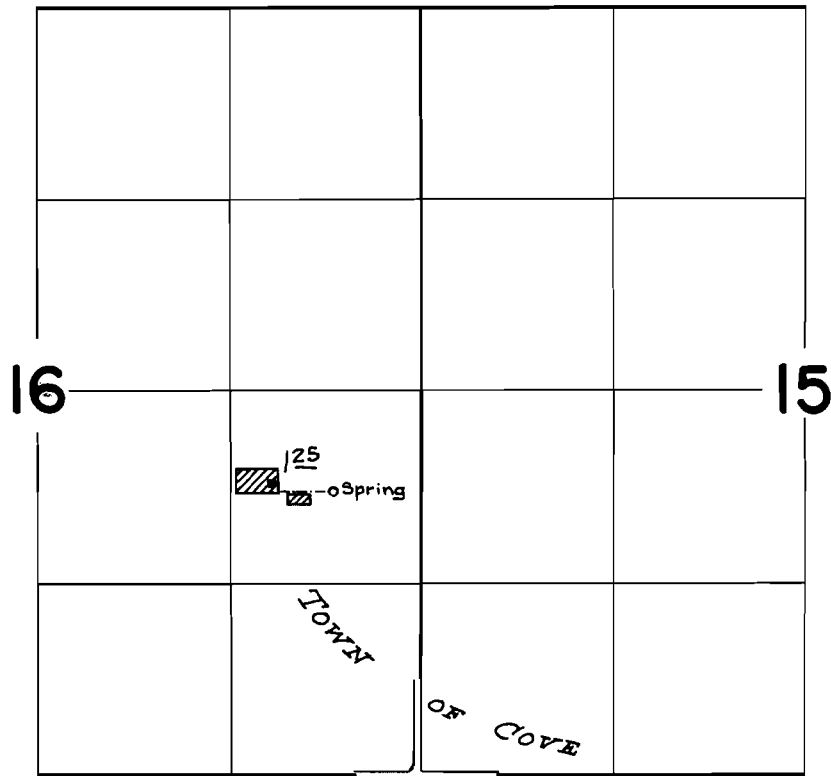

FINAL PROOF SURVEY UNDER

Application No. 33508.. Permit No. 26550..
IN NAME OF

PRESTON W. HOADLEY

Surveyed SEPT. 24 1963, by C. R. BAKER

st