


T.2S. R.39E.W.M.

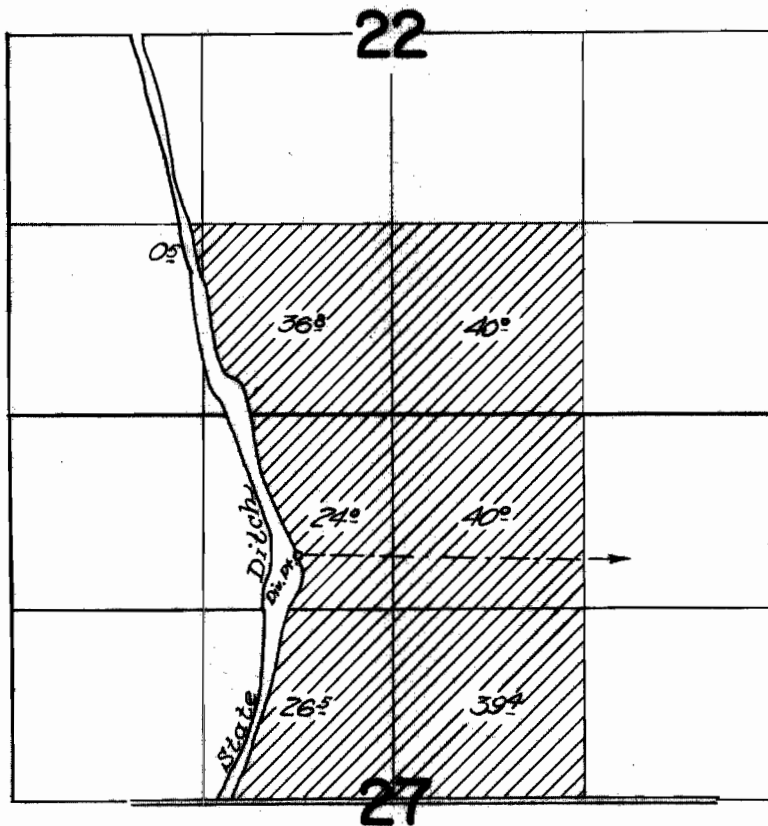

FINAL PROOF SURVEY
UNDER

Application No. 34502... Permit No. 27088...
IN NAME OF

WILLIAM D. & LILLIE B. MILLER

Surveyed Oct. 3, 1963, by C. Baker...