


T.3S.R.38E.W.M.

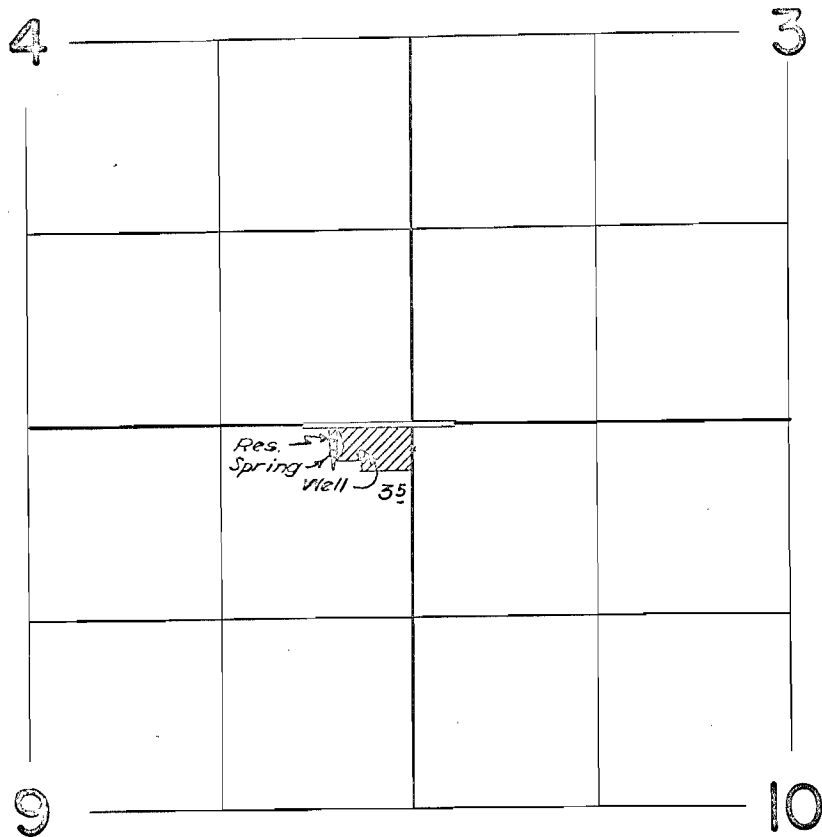

FINAL PROOF SURVEY
UNDER

G-1055 G-1697
R-34437 R-2581
Application No. 34504... Permit No. 27160...
IN NAME OF

.....ROY H. & JUNE BYRON.....

Surveyed Oct. 2... 1963, by C.R. Baker..