


T.3S.R.38E.W.M.

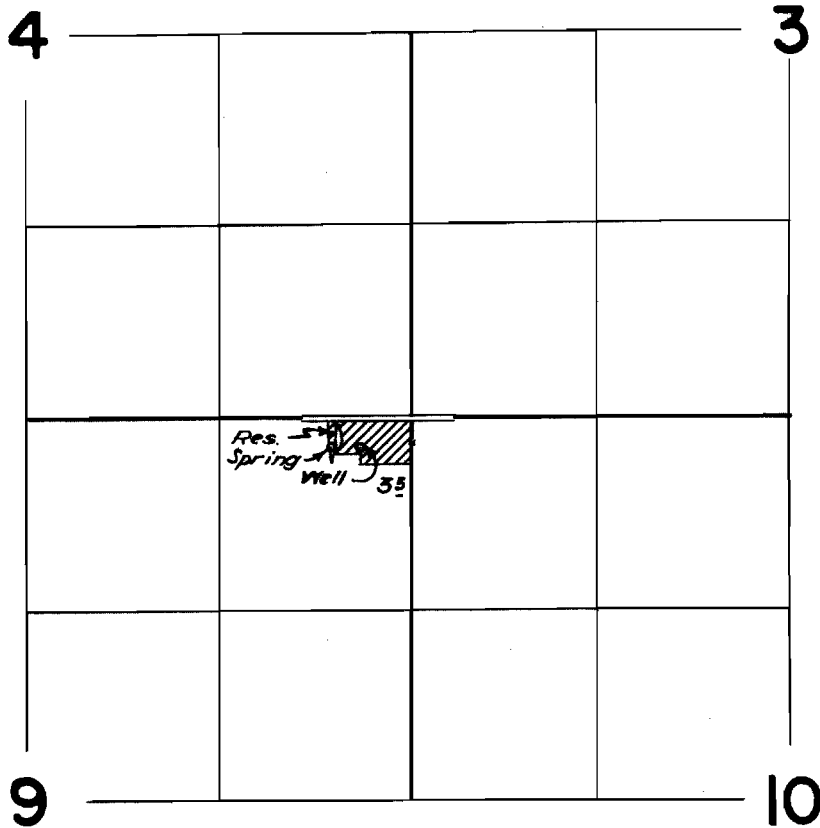

FINAL PROOF SURVEY
UNDER

G-1655 G-1697
R-34437 R-2581
Application No. 34584... Permit No. 27180.....
IN NAME OF

.....ROY H. & JUNE BYRON.....

Surveyed Oct. 2, 1963, by C.R. Baker.....