


T.3S.R.40E.W.M.

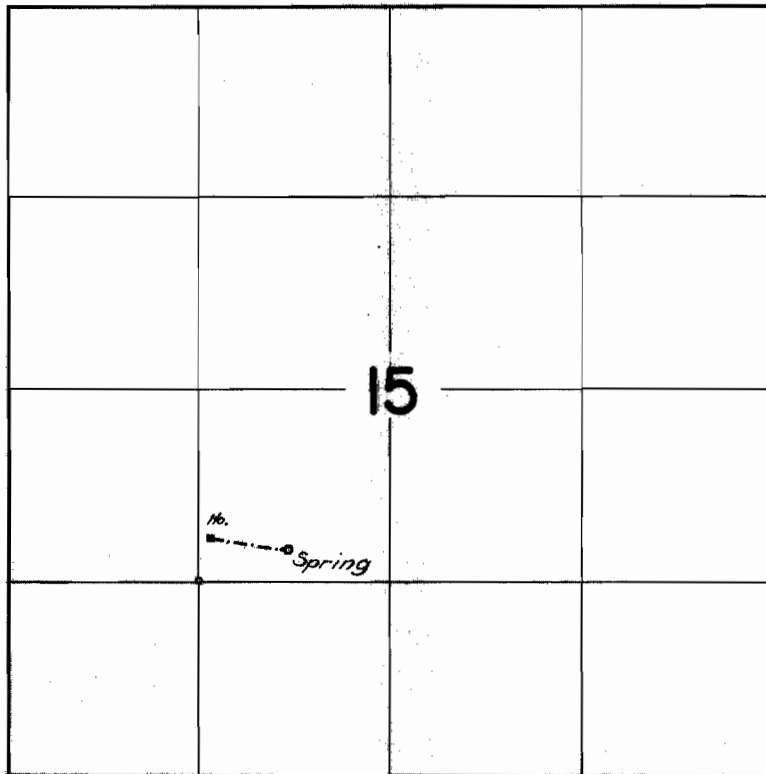

FINAL PROOF SURVEY
UNDER

Application No. 34547... Permit No. 27192...
IN NAME OF

.....
ADELMA L. KELLOGG
.....

Surveyed *Sept. 24 1963*, by *C. R. Baker*