


T.28&3 S.R.39E.W.M.

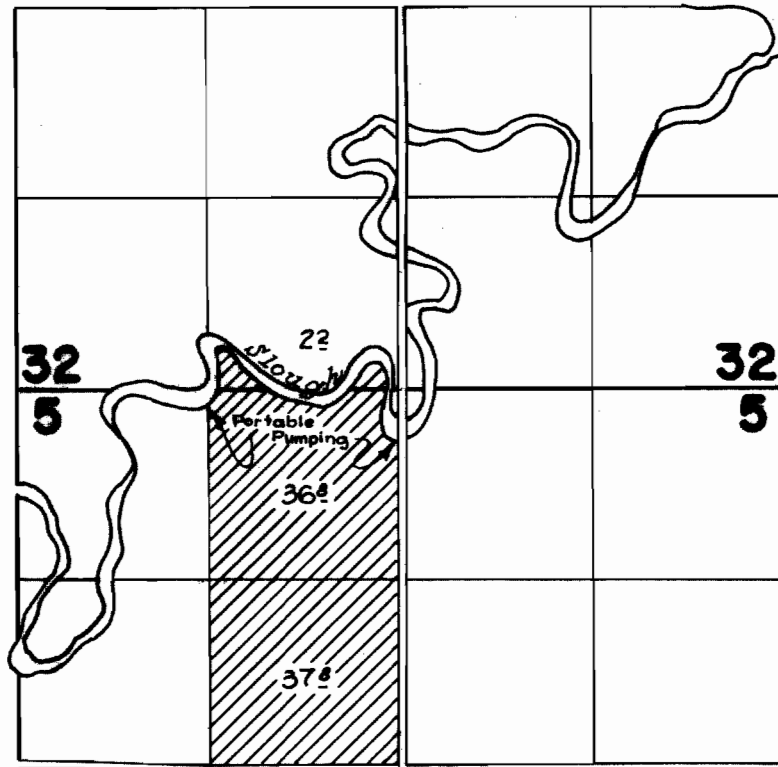

FINAL PROOF SURVEY
UNDER

Application No. 24649... Permit No. 27217.
IN NAME OF

STANLEY & MAURICE WEISHAAR

Surveyed Sept. 24 1963, by C. D. BAKER