


T.28&3S.R.40E.W.M.

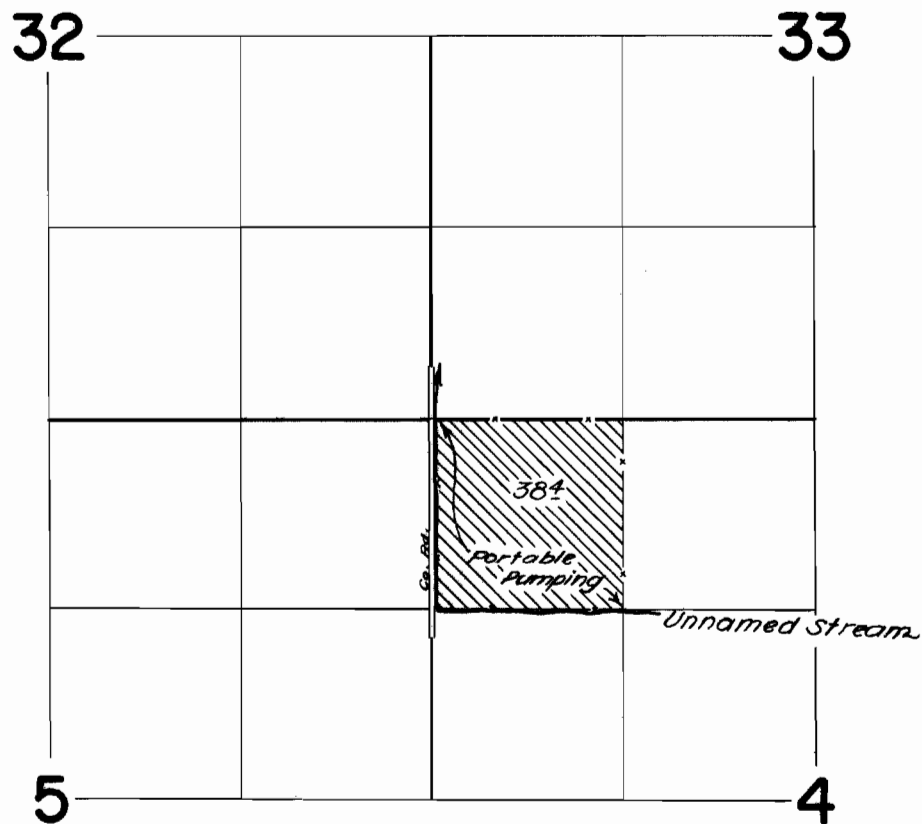

**FINAL PROOF SURVEY**  
UNDER

Application No. 37393... Permit No. 27834...  
IN NAME OF

GRANT CONLEY

Surveyed Sept. 28 1963, by G.R. Baker