


G 2055

T. 2 N. R. 12 E. W. M.

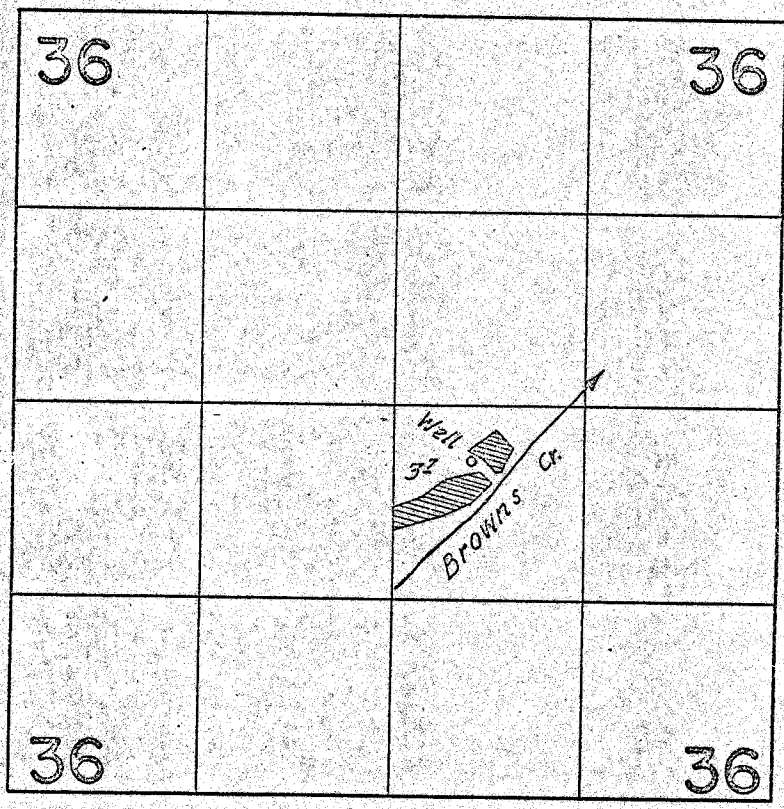

FINAL PROOF SURVEY
UNDER

Application No. G-2232... Permit No. G-2055
IN NAME OF

Leo V. Moore

Surveyed April 8, 1963, by *Larry Johnson*