


Survey
P-3226
P-3227

T.3S.R.13E.W.M.

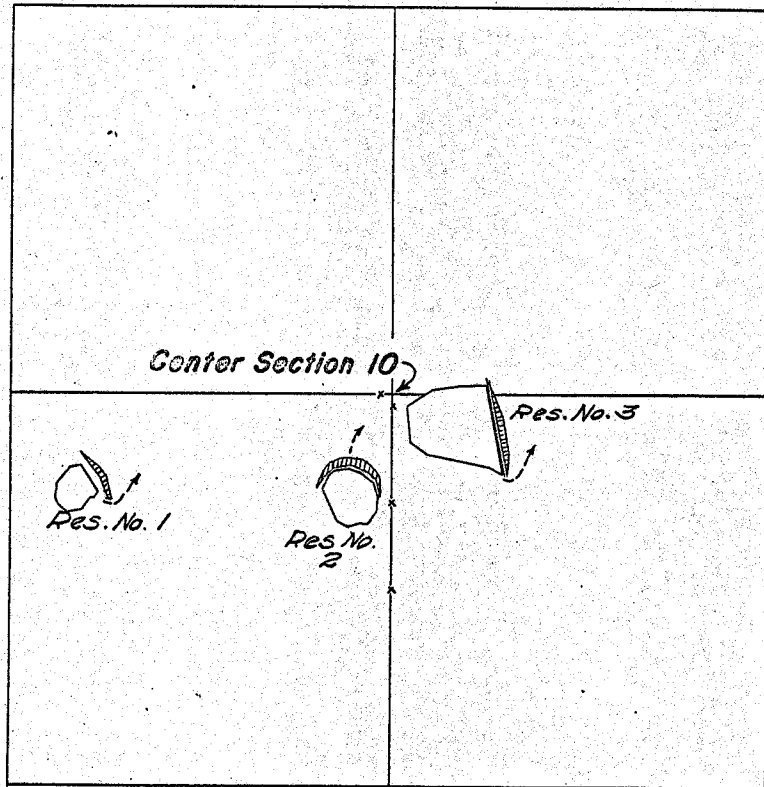

Scale : 1" = 660'

FINAL PROOF SURVEY UNDER

R-38465 R-3226
Application No. R-38466 Permit No. R-3227.
IN NAME OF

WILBUR HENDRICKS

Surveyed Oct. 30, 1963, by *R. Jackson*