


T. I. S. R. 4 W. W. M.

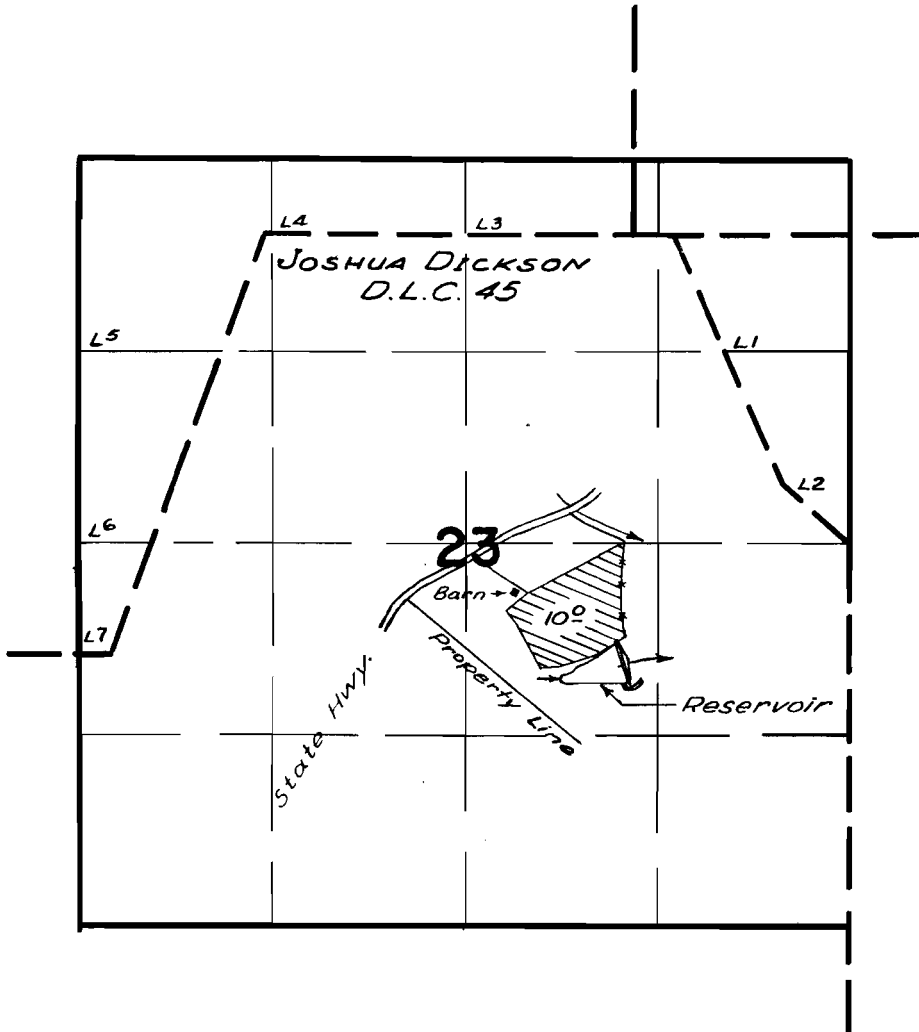

FINAL PROOF SURVEY
UNDER

R-34166 R-2512
Application No. 34167 Permit No. 26995
IN NAME OF

ROBERT L. PIPER

Surveyed 26 Dec. 1962, by *T. M. Besh*